


WATER WELL RECORD Form WWC-5 KSA 82a-1212

1 LOCATION OF WATER WELL:	Fraction	Section Number	Township Number	Range Number
County: ELLIS	SE 1/4 SE 1/4 SE 1/4	29	T 13 S	R 18 EW

Distance and direction from nearest town or city street address of well if located within city?
 2725 AUGUSTA HAYS KS

2 WATER WELL OWNER: SCHUMACHER CONSTRUCTION
 Board of Agriculture, Division of Water Resources
 RR#, St. Address, Box #: C/O LaVern Schumacher
 City, State, ZIP Code: HYAS KS 67601
 Application Number:

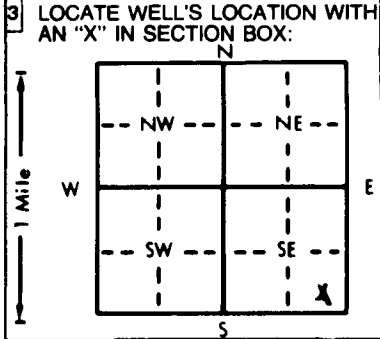

4 DEPTH OF COMPLETED WELL: 88 ft. ELEVATION:

Depth(s) Groundwater Encountered 1. 58 ft. 2. ft. 3. ft.

WELL'S STATIC WATER LEVEL: 58 ft. below land surface measured on mo/day/yr 5-16-00

Pump test data: Well water was ft. after hours pumping gpm

Est. Yield: 40 gpm: Well water was ft. after hours pumping gpm

Bore Hole Diameter: 10 in. to 88 ft., and in. to ft.

WELL WATER TO BE USED AS:

5 Public water supply	8 Air conditioning	11 Injection well
1 Domestic	3 Feedlot	6 Oil field water supply
2 Irrigation	4 Industrial	9 Dewatering
	XX Lawn and garden only	10 Monitoring well
		12 Other (Specify below)

Was a chemical/bacteriological sample submitted to Department? Yes No XX; If yes, mo/day/yr sample was submitted

Water Well Disinfected? Yes No XX

5 TYPE OF BLANK CASING USED:

1 Steel	3 RMP (SR)	5 Wrought iron	8 Concrete tile	CASING JOINTS: Glued XX Clamped
XX PVC	4 ABS	6 Asbestos-Cement	9 Other (specify below)	Welded
		7 Fiberglass		Threaded

Blank casing diameter: 5 in. to 68 ft., Dia in. to ft., Dia in. to ft.

Casing height above land surface: 18 in., weight 160 lbs./ft. Wall thickness or gauge No.

TYPE OF SCREEN OR PERFORATION MATERIAL:

1 Steel	3 Stainless steel	5 Fiberglass	8 RMP (SR)	10 Asbestos-cement
2 Brass	4 Galvanized steel	6 Concrete tile	9 ABS	11 Other (specify)
				12 None used (open hole)

SCREEN OR PERFORATION OPENINGS ARE:

1 Continuous slot	XX Mill slot	5 Gauzed wrapped	8 Saw cut	11 None (open hole)
2 Louvered shutter	4 Key punched	6 Wire wrapped	9 Drilled holes	
		7 Torch cut	10 Other (specify)	

SCREEN-PERFORATED INTERVALS: From 68 ft. to 88 ft., From ft. to ft.

GRAVEL PACK INTERVALS: From 40 ft. to 88 ft., From ft. to ft.

6 GROUT MATERIAL: 1 Neat cement 2 Cement grout XX Bentonite 4 Other

Grout intervals: From 0 ft. to 30 ft., From ft. to ft.

What is the nearest source of possible contamination:

1 Septic tank	4 Lateral lines	7 Pit privy	10 Livestock pens	14 Abandoned water well
2 Sewer lines	5 Cess pool	8 Sewage lagoon	11 Fuel storage	15 Oil well/Gas well
3 Watertight sewer lines	6 Seepage pit	9 Feedyard	12 Fertilizer storage	16 Other (specify below)
			13 Insecticide storage	

Direction from well? How many feet?

FROM	TO	LITHOLOGIC LOG	FROM	TO	PLUGGING INTERVALS
0	6	SURFACE CLAY			
6	28	MED GRAY CLAY			
28	38	SOFT CLAY			
38	55	HARD BROWN CLAY			
55	70	DARK & LIGHT CONGLOMERATE CLAY			
70	75	FINE SAND			
75	85	MED SAND			
85	88	BLUE SHALE			

7 CONTRACTOR'S OR LANDOWNER'S CERTIFICATION: This water well was XX constructed, (2) reconstructed, or (3) plugged under my jurisdiction and was completed on (mo/day/year) 5-16-00 and this record is true to the best of my knowledge and belief. Kansas Water Well Contractor's License No. 444 This Water Well Record was completed on (mo/day/yr) 5-16-00 under the business name of ANDY ANDERSON DRILLING by (signature) Andy Anderson

INSTRUCTIONS: Use typewriter or ball point pen. PLEASE PRESS FIRMLY and PRINT clearly. Please fill in blanks, underline or circle the correct answers. Send top three copies to Kansas Department of Health and Environment, Bureau of Water, Topeka, Kansas 66620-0001. Telephone: 913-296-5545. Send one to WATER WELL OWNER and retain one for your records.

OFFICE USE ONLY
T
R
EW
SEC.
1/4
1/4
1/4