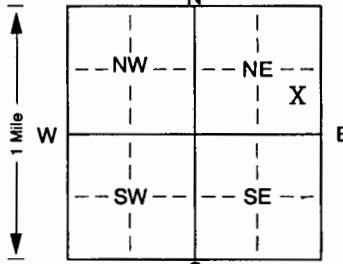


1] LOCATION OF WATER WELL: Fraction NE 1/4 SE 1/4 NE 1/4 Section Number 29 Township Number T 13 S Range Number R 18 E/W
 County: Ellis

Distance and direction from nearest town or city street address of well if located within city?
3600 Fairway, Hays KS

2] WATER WELL OWNER: Doris McKinzie
 RR#, St. Address, Box # : 3600 Fairway Board of Agriculture, Division of Water Resources
 City, State, ZIP Code : Hays KS 67601 Application Number:

3] LOCATE WELL'S LOCATION WITH AN "X" IN SECTION BOX:

 4] DEPTH OF COMPLETED WELL: 66 ft. ELEVATION: upland
 Depth(s) Groundwater Encountered 1. 60 ft. 2. 60 ft. 3. 60 ft.
 WELL'S STATIC WATER LEVEL 35 ft. below land surface measured on mo/day/yr 3/30/01
 Pump test data: Well water was 35 ft. after 2 hours pumping 20 gpm
 Est. Yield 20 gpm: Well water was 35 ft. after 2 hours pumping 20 gpm
 Bore Hole Diameter: 10 in. to 66 ft., and 10 in. to 66 ft.
 WELL WATER TO BE USED AS:
 1 Domestic 3 Feedlot 6 Oil field water supply 9 Dewatering 12 Other (Specify below)
 2 Irrigation 4 Industrial 7 Domestic (lawn & garden) 10 Monitoring well
 Was a chemical/bacteriological sample submitted to Department? Yes. No X; If yes, mo/day/yr sample was submitted
 Water Well Disinfected? Yes X No

5] TYPE OF BLANK CASING USED: 2 5 Wrought iron 8 Concrete tile CASING JOINTS: Glued X Clamped
 1 Steel 3 RMP (SR) 6 Asbestos-Cement 9 Other (specify below) Welded
2 PVC 4 ABS 7 Fiberglass Threaded
 Blank casing diameter 5 in. to 46 ft., Dia 5 in. to 46 ft., Dia 5 in. to 46 ft.
 Casing height above land surface 24 in., weight 2.29 lbs./ft. Wall thickness or gauge No. 26
 TYPE OF SCREEN OR PERFORATION MATERIAL: 7 7 PVC 10 Asbestos-cement
 1 Steel 3 Stainless steel 5 Fiberglass 8 RMP (SR) 11 Other (specify)
 2 Brass 4 Galvanized steel 6 Concrete tile 9 ABS 12 None used (open hole)
 SCREEN OR PERFORATION OPENINGS ARE: 8 5 Gauzed wrapped 8 Saw cut 11 None (open hole)
 1 Continuous slot 3 Mill slot 6 Wire wrapped 9 Drilled holes
 2 Louvered shutter 4 Key punched 7 Torch cut 10 Other (specify) ft.
 SCREEN-PERFORATED INTERVALS: From 66 ft. to 46 ft., From 66 ft. to 46 ft., From 66 ft. to 46 ft.
 GRAVEL PACK INTERVALS: From 20 ft. to 66 ft., From 20 ft. to 66 ft., From 20 ft. to 66 ft.

6] GROUT MATERIAL: 3 1 Neat cement 2 Cement grout 3 Bentonite 4 Other
 Grout Intervals: From 0 ft. to 20 ft., From 0 ft. to 20 ft., From 0 ft. to 20 ft.
 What is the nearest source of possible contamination:
 1 Septic tank 4 Lateral lines 7 Pit privy 10 Livestock pens 14 Abandoned water well
 2 Sewer lines 5 Cess pool 8 Sewage lagoon 11 Fuel storage 15 Oil well/Gas well
 3 Watertight sewer lines 6 Seepage pit 9 Feedyard 12 Fertilizer storage 16 Other (specify below)
 13 Insecticide storage
 Direction from well? How many feet?

FROM	TO	LITHOLOGIC LOG	FROM	TO	PLUGGING INTERVALS
0	3	Topsoil			
3	29	Gumbo			
29	43	Loose white rock			
43	46	Gumbo			
46	56	Loose white rock			
56	58	Clay			
58	60	Sand			
60	66	Shale			

7] CONTRACTOR'S OR LANDOWNER'S CERTIFICATION: This water well was (1) constructed, (2) reconstructed, or (3) plugged under my jurisdiction and was completed on (mo/day/year) 3/30/01 and this record is true to the best of my knowledge and belief. Kansas Water Well Contractor's Licence No. 199 This Water Well Record was completed on (mo/day/yr) 4/3/01 under the business name of Karst Water Well Drilling & Service, Inc. by (signature) Mel Kras