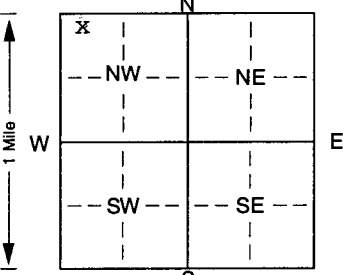


1 LOCATION OF WATER WELL: Fraction NW 1/4 NW 1/4 NW 1/4 Section Number 29 Township Number T 13 S Range Number R 18 ~~E~~W  
 County: ELLIS  
 Distance and direction from nearest town or city street address of well if located within city?  
 3802 BUTTERFIELD RD HAYS KS

2 WATER WELL OWNER: STEVE MAYO  
 RR#, St. Address, Box #: 3802 BUTTERFIELD RD Board of Agriculture, Division of Water Resources  
 City, State, ZIP Code: HAYS KS 67601 Application Number:

3 LOCATE WELL'S LOCATION WITH AN "X" IN SECTION BOX:  
  
 4 DEPTH OF COMPLETED WELL: 95 ft. ELEVATION:  
 Depth(s) Groundwater Encountered 1. 75 ft. 2. ft. 3. 7-2-01 ft.  
 WELL'S STATIC WATER LEVEL: 55 ft. below land surface measured on mo/day/yr  
 Pump test data: Well water was 50 ft. after hours pumping gpm  
 Est. Yield 50 gpm: Well water was 10 ft. after hours pumping gpm  
 Bore Hole Diameter: 10 in. to 95 ft., and in. to ft.  
 WELL WATER TO BE USED AS:  
 5 Public water supply 8 Air conditioning 11 Injection well  
 1 Domestic 3 Feedlot 6 Oil field water supply 9 Dewatering 12 Other (Specify below)  
 2 Irrigation 4 Industrial ~~XX~~ Domestic (lawn & garden) 10 Monitoring well  
 Was a chemical/bacteriological sample submitted to Department? Yes. No. ~~XX~~; If yes, mo/day/yr sample was submitted  
 Water Well Disinfected? Yes No ~~XX~~

5 TYPE OF BLANK CASING USED:  
 1 Steel 3 RMP (SR) 5 Wrought iron 8 Concrete tile CASING JOINTS: Glued. ~~XX~~ Clamped.  
~~XX~~ PVC 4 ABS 6 Asbestos-Cement 9 Other (specify below) Welded  
 7 Fiberglass Threaded.  
 Blank casing diameter 5 in. to 75 ft., Dia in. to ft., Dia in. to ft.  
 Casing height above land surface 18 in., weight 160 lbs./ft. Wall thickness or gauge No.  
 TYPE OF SCREEN OR PERFORATION MATERIAL: ~~XX~~ PVC 10 Asbestos-cement  
 1 Steel 3 Stainless steel 5 Fiberglass 8 RMP (SR) 11 Other (specify)  
 2 Brass 4 Galvanized steel 6 Concrete tile 9 ABS 12 None used (open hole)  
 SCREEN OR PERFORATION OPENINGS ARE:  
 1 Continuous slot 5 Gauzed wrapped 8 Saw cut 11 None (open hole)  
 2 Louvered shutter 4 Key punched 6 Wire wrapped 9 Drilled holes  
 7 Torch cut 10 Other (specify) ft.  
 SCREEN-PERFORATED INTERVALS: From 75 ft. to 95 ft., From ft. to ft.  
 GRAVEL PACK INTERVALS: From 50 ft. to 95 ft., From ft. to ft.

6 GROUT MATERIAL: 1 Neat cement 2 Cement grout ~~XX~~ Bentonite 4 Other  
 Grout Intervals: From 0 ft. to 30 ft., From ft. to ft., From ft. to ft.  
 What is the nearest source of possible contamination:  
 1 Septic tank 4 Lateral lines 7 Pit privy 10 Livestock pens 14 Abandoned water well  
 2 Sewer lines 5 Cess pool 8 Sewage lagoon 11 Fuel storage 15 Oil well/Gas well  
 3 Watertight sewer lines 6 Seepage pit 9 Feedyard 12 Fertilizer storage 16 Other (specify below)  
 13 Insecticide storage  
 Direction from well? How many feet?

FROM	TO	LITHOLOGIC LOG	FROM	TO	PLUGGING INTERVALS
0	5	SURFACE CLAY			
5	30	HARD YELLOW CLAY			
30	50	HARD GRAY CLAY			
50	70	MED YELLOW CLAY			
70	80	HARD BLUE MUD			
80	90	MED SAND			
90	95	MED TO LARGE SAND			
95	96	BLUE SHALE			

7 CONTRACTOR'S OR LANDOWNER'S CERTIFICATION: This water well was ~~(1)~~ constructed, (2) reconstructed, or (3) plugged under my jurisdiction and was completed on (mo/day/year) 7-5-01 and this record is true to the best of my knowledge and belief. Kansas Water Well Contractor's Licence No. 444 This Water Well Record was completed on (mo/day/yr) 7-6-01 under the business name of ANDY ANDERSON DRILLING by (signature) Andy Anderson