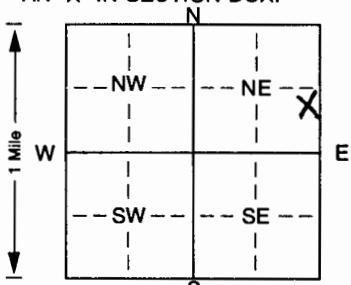


WATER WELL RECORD Form WWC-5 KSA 82a-1212 ID No.

1 LOCATION OF WATER WELL: County: ELLIS	Fraction NE ¼ SE ¼ NE ¼	Section Number 29	Township Number T 13 S	Range Number R 18 EW
--	----------------------------	----------------------	---------------------------	-------------------------

Distance and direction from nearest town or city street address of well if located within city?
1002 W 37th HAYS KS

2 WATER WELL OWNER: SHELTON RENZ
 RR#, St. Address, Box # : 1002 W 37th
 City, State, ZIP Code : HAYS KS 67601
 Board of Agriculture, Division of Water Resources
 Application Number:

3 LOCATE WELL'S LOCATION WITH AN "X" IN SECTION BOX: 	4 DEPTH OF COMPLETED WELL: 55 ft. ELEVATION: Depth(s) Groundwater Encountered 1. 39 ft. 2. ft. 3. ft. WELL'S STATIC WATER LEVEL 39 ft. below land surface measured on mo/day/yr 6-6-02 Pump test data: Well water was ft. after hours pumping gpm Est. Yield 12 gpm: Well water was ft. after hours pumping gpm Bore Hole Diameter 10 in. to 55 ft., and in. to ft. WELL WATER TO BE USED AS: 5 Public water supply 8 Air conditioning 11 Injection well 1 Domestic 3 Feedlot 6 Oil field water supply 9 Dewatering 12 Other (Specify below) 2 Irrigation 4 Industrial <input checked="" type="checkbox"/> Domestic (lawn & garden) 10 Monitoring well Was a chemical/bacteriological sample submitted to Department? Yes. No. <input checked="" type="checkbox"/> ; If yes, mo/day/yr sample was submitted Water Well Disinfected? Yes No <input checked="" type="checkbox"/>
--	---

5 TYPE OF BLANK CASING USED:
 1 Steel 3 RMP (SR) 5 Wrought iron 8 Concrete tile CASING JOINTS: Glued Clamped
 PVC 4 ABS 6 Asbestos-Cement 9 Other (specify below) Welded
 7 Fiberglass Threaded
 Blank casing diameter 5 in. to 35 ft., Dia in. to ft., Dia in. to ft.
 Casing height above land surface 18 in., weight 160 lbs./ft. Wall thickness or gauge No.
 TYPE OF SCREEN OR PERFORATION MATERIAL:
 1 Steel 3 Stainless steel 5 Fiberglass PVC 10 Asbestos-cement
 2 Brass 4 Galvanized steel 6 Concrete tile 8 RMP (SR) 11 Other (specify)
 9 ABS 12 None used (open hole)
 SCREEN OR PERFORATION OPENINGS ARE:
 1 Continuous slot Mill slot 5 Gauzed wrapped 8 Saw cut 11 None (open hole)
 2 Louvered shutter 4 Key punched 6 Wire wrapped 9 Drilled holes
 7 Torch cut 10 Other (specify) ft.
 SCREEN-PERFORATED INTERVALS: From 35 ft. to 55 ft., From ft. to ft.
 GRAVEL PACK INTERVALS: From 30 ft. to 55 ft., From ft. to ft.

6 GROUT MATERIAL: 1 Neat cement 2 Cement grout Bentonite 4 Other
 Grout Intervals: From 0 ft. to 30 ft., From ft. to ft., From ft. to ft.
 What is the nearest source of possible contamination:
 1 Septic tank 4 Lateral lines 7 Pit privy 10 Livestock pens 14 Abandoned water well
 2 Sewer lines 5 Cess pool 8 Sewage lagoon 11 Fuel storage 15 Oil well/Gas well
 3 Watertight sewer lines 6 Seepage pit 9 Feedyard 12 Fertilizer storage 16 Other (specify below)
 13 Insecticide storage
 Direction from well? How many feet?

FROM	TO	LITHOLOGIC LOG	FROM	TO	PLUGGING INTERVALS
0	10	SURFACE CLAY			
10	30	HARD YELLOW CLAY			
30	40	FINE SAND			
40	48	MED SAND			
48	55	SOAPSTONE			

7 CONTRACTOR'S OR LANDOWNER'S CERTIFICATION: This water well was constructed, reconstructed, or plugged under my jurisdiction and was completed on (mo/day/year) 6-6-02 and this record is true to the best of my knowledge and belief. Kansas Water Well Contractor's Licence No. 444 This Water Well Record was completed on (mo/day/yr) 6-6-02 under the business name of ANDY ANDERSON DRILLING by (signature) *Andy Anderson*

INSTRUCTIONS: Use typewriter or ball point pen. PLEASE PRESS FIRMLY and PRINT clearly. Please fill in blanks, underline or circle the correct answers. Send top three copies to Kansas Department of Health and Environment, Bureau of Water, Topeka, Kansas 66620-0001. Telephone 785-296-5524. Send one to WATER WELL OWNER and retain one for your records. Fee of \$5.00 for each constructed well.