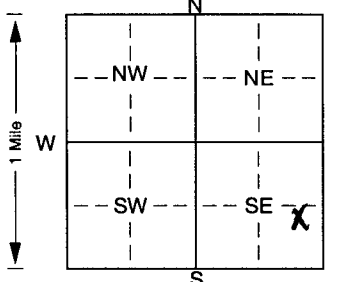


1 LOCATION OF WATER WELL: Fraction NE 1/4 NE SE SE 1/4 Section Number 33 Township Number T 13 S Range Number R 18 EW
 County: Ellis

Distance and direction from nearest town or city street address of well if located within city?
40' N 21' E of SE corner of former Apex Bldg (E. 18th + V. no St)

2 WATER WELL OWNER: Craddock Development
 RR#, St. Address, Box #: Box 9000 Board of Agriculture, Division of Water Resources
 City, State, ZIP Code: Comerio TX 79105 Application Number:

3 LOCATE WELL'S LOCATION WITH AN "X" IN SECTION BOX:

 4 DEPTH OF COMPLETED WELL: 37.0 ft. ELEVATION: 2001.69
 Depth(s) Groundwater Encountered 1. 32.50 ft. 2. ft. 3. ft.
 WELL'S STATIC WATER LEVEL 1969.19 ft. below land surface measured on mo/day/yr 7-21-03
 Pump test data: Well water was ft. after hours pumping gpm
 Est. Yield gpm: Well water was ft. after hours pumping gpm
 Bore Hole Diameter: 2 in. to 31.0 ft., and in. to ft.
 WELL WATER TO BE USED AS: 5 Public water supply 8 Air conditioning 11 Injection well
 1 Domestic 3 Feedlot 6 Oil field water supply 9 Dewatering 12 Other (Specify below)
 2 Irrigation 4 Industrial 7 Domestic (lawn & garden) 10 Monitoring well VOBW-1
 Was a chemical/bacteriological sample submitted to Department? Yes. No. ; If yes, mo/day/yr sample was submitted
 Water Well Disinfected? Yes No

5 TYPE OF BLANK CASING USED:
 1 Steel 3 RMP (SR) 5 Wrought iron 8 Concrete tile CASING JOINTS: Glued. Clamped.
 2 PVC 4 ABS 6 Asbestos-Cement 9 Other (specify below) Welded
 Blank casing diameter 2 in. to 27.0 ft., Dia. in. to ft., Dia. in. to ft.
 Casing height above land surface: 0.34 in., weight lbs./ft. Wall thickness or gauge No.
 TYPE OF SCREEN OR PERFORATION MATERIAL:
 1 Steel 3 Stainless steel 5 Fiberglass 7 PVC 10 Asbestos-cement
 2 Brass 4 Galvanized steel 6 Concrete tile 8 RMP (SR) 11 Other (specify)
 9 ABS 12 None used (open hole)
 SCREEN OR PERFORATION OPENINGS ARE:
 1 Continuous slot 3 Mill slot 5 Gauzed wrapped 8 Saw cut 11 None (open hole)
 2 Louvered shutter 4 Key punched 6 Wire wrapped 7 Torch cut 9 Drilled holes
 10 Other (specify) ft.
 SCREEN-PERFORATED INTERVALS: From: 27.0 ft. to 37.0 ft., From ft. to ft.
 GRAVEL PACK INTERVALS: From: 24.0 ft. to 37.0 ft., From ft. to ft.

6 GROUT MATERIAL: Neat cement Cement grout Bentonite 4 Other
 Grout Intervals: From: 00 ft. to 20 ft., From 20 ft. to 220 ft., From 220 ft. to 240 ft.
 What is the nearest source of possible contamination:
 1 Septic tank 4 Lateral lines 7 Pit privy 10 Livestock pens 14 Abandoned water well
 2 Sewer lines 5 Cess pool 8 Sewage lagoon 11 Fuel storage 15 Oil well/Gas well
 3 Watertight sewer lines 6 Seepage pit 9 Feedyard 12 Fertilizer storage 16 Other (specify below)
 13 Insecticide storage
 Direction from well? How many feet?

FROM	TO	LITHOLOGIC LOG	FROM	TO	PLUGGING INTERVALS
00	0.5	concrete			
0.5	40	Sandy clay, bn, mst, sft, med plast, fine sand, sm gravel, no odor			
40	90	Sandy clay, lt bn when stony, sft mst, st/med plast, fine sand, gravel, med nodules			
90	19.0	Sandy silt, lt gray bn, sft, st mst, med, fine sand, med nodules, silt odor			
19.0	24.0	Silty sand, lt gray bn, mst, unbr, fine sand, sly clay, st plast, silt odor			
24.0	29.0	Clay, silt, lt bn, iron smtg, sft, very mst, med plast, no odor			
29.0	37.0	Sandy clay, bn, mst, stiff, mst, med plast, no odor			

7 CONTRACTOR'S OR LANDOWNER'S CERTIFICATION: This water well was (1) constructed, (2) reconstructed, or (3) plugged under my jurisdiction and was completed on (mo/day/year) 7-21-03 and this record is true to the best of my knowledge and belief. Kansas Water Well Contractor's Licence No. SS-4 This Water Well Record was completed on (mo/day/yr) 8-11-03 under the business name of Woodruff Pump & Well by (signature) [Signature]