


1 LOCATION OF WATER WELL: Fraction SE SW NW SE Section Number 20 Township Number T 13 S Range Number R 18 EW
 County: ELLIS Distance and direction from nearest town or city street address of well if located within city?

1400 W 43RD HAYS KS

2 WATER WELL OWNER: KIRK MASKA Board of Agriculture, Division of Water Resources
 RR#, St. Address, Box # : 1400 W 43RD Application Number:
 City, State, ZIP Code : HAYS KS 67601

3 LOCATE WELL'S LOCATION WITH AN "X" IN SECTION BOX:

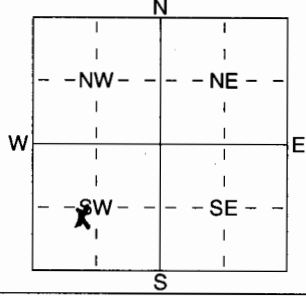

4 DEPTH OF COMPLETED WELL 7.6 ft. ELEVATION:
 Depth(s) Groundwater Encountered 1 5.6 ft. 2 ft. 3 ft.
 WELL'S STATIC WATER LEVEL 5.6 ft. below land surface measured on mo/day/yr 4-2-04
 Pump test data: Well water was ft. after hours pumping gpm
 Est. Yield 1.5 gpm: Well water was ft. after hours pumping gpm
 WELL WATER TO BE USED AS: 5 Public water supply 8 Air conditioning 11 Injection well
 1 Domestic 3 Feedlot 6 Oil field water supply 9 Dewatering 12 Other (Specify below)
 2 Irrigation 4 Industrial ~~7 Domestic (lawn & garden)~~ 10 Monitoring well
 Was a chemical/bacteriological sample submitted to Department? Yes No XX ; If yes, mo/day/yr sample was submitted
 Water Well Disinfected? Yes No XX

5 TYPE OF BLANK CASING USED: 5 Wrought iron 8 Concrete tile CASING JOINTS: Glued Clamped
 1 Steel 3 RMP (SR) 6 Asbestos-Cement 9 Other (specify below) Welded
~~2 PVC~~ 4 ABS 7 Fiberglass Threaded
 Blank casing diameter 5 in. to 5.6 ft., Dia in. to ft., Dia in. to ft.
 Casing height above land surface 1.8 in., weight 1.60 lbs./ft. Wall thickness or gauge No.
 TYPE OF SCREEN OR PERFORATION MATERIAL: ~~7 PVC~~ 10 Asbestos-Cement
 1 Steel 3 Stainless Steel 5 Fiberglass 8 RMP (SR) 11 Other (Specify)
 2 Brass 4 Galvanized Steel 6 Concrete tile 9 ABS 12 None used (open hole)
 SCREEN OR PERFORATION OPENINGS ARE: 5 Gauzed wrapped 8 Saw cut 11 None (open hole)
 1 Continuous slot ~~3 Mill slot~~ 6 Wire wrapped 9 Drilled holes
 2 Louvered shutter 4 Key punched 7 Torch cut 10 Other (specify) ft.
 SCREEN-PERFORATED INTERVALS: From 5.6 ft. to 7.6 ft., From ft. to ft.
 From ft. to ft., From ft. to ft.
 GRAVEL PACK INTERVALS: From 4.0 ft. to 7.6 ft., From ft. to ft.
 From ft. to ft., From ft. to ft.

6 GROUT MATERIAL: 1 Neat cement 2 Cement grout ~~3 Bentonite~~ 4 Other
 Grout Intervals: From 0 ft. to 3.0 ft., From ft. to ft., From ft. to ft.
 What is the nearest source of possible contamination:
 1 Septic tank 4 Lateral lines 7 Pit privy 10 Livestock pens 14 Abandoned water well
 2 Sewer lines 5 Cess pool 8 Sewage lagoon 11 Fuel storage 15 Oil well/Gas well
 3 Watertight sewer lines 6 Seepage pit 9 Feedyard 12 Fertilizer storage 16 Other (specify below)
 13 Insecticide storage
 Direction from well? How many feet?

FROM	TO	LITHOLOGIC LOG	FROM	TO	PLUGGING INTERVALS
0	10	SURFACE CLAY			
10	30	HARD YELLOW CLAY			
30	40	WHIE ROCK - GRAY CLAY			
40	50	FINE SAND			
50	60	MED SAND			
60	65	MED TO LARGE SAND			
65	70	SOAPSTONE			
70	76	BLUE SHALE			

7 CONTRACTOR'S OR LANDOWNER'S CERTIFICATION: This water well was (XX) constructed, (2) reconstructed, or (3) plugged under my jurisdiction and was completed on (mo/day/year) 4-2-04 and this record is true to the best of my knowledge and belief. Kansas Water Well Contractor's Licence No 444 This Water Well Record was completed on (mo/day/yr) 4-2-04 under the business name of ANDY ANDERSON DRILLING by (signature) Andy Anderson