

1 LOCATION OF WATER WELL:	Fraction	Section Number	Township Number	Range Number
County: <b>Ellis</b>	<b>SW 1/4 SW 1/4 SW 1/4</b>	<b>29</b>	<b>13</b>	<b>18 W</b>

Distance and direction from nearest town or city street address of well if located within city?  
**Corner of Alt. Hwy 183 and 27<sup>th</sup> St., Hays, KS**

2 WATER WELL OWNER:	<b>KDHE</b>		
RR#, St. Address, Box #	<b>1000 SW Jackson St., Ste 410</b>		Board of Agriculture, Division of Water Resources
City, State, ZIP Code :	<b>Topeka, KS 66612-1367</b>		Application Number:

3 MARK WELL'S LOCATION WITH AN "X" IN SECTION BOX:

4 DEPTH OF WELL 50.06 ft. Well originally completed at 47.4 ft. bgs

WELL'S STATIC WATER LEVEL 26.68 ft.


WELL WAS USED AS:

- |              |                              |                           |
|--------------|------------------------------|---------------------------|
| 1 Domestic   | 5 Public Water Supply        | 9 Dewatering              |
| 2 Irrigation | 6 Oil Field Water Supply     | <b>10 Monitoring Well</b> |
| 3 Feedlot    | 7 Lawn and Garden (domestic) | 11 Injection Well         |
| 4 Industrial | 8 Air Conditioning           | 12 Other _____            |

Was a chemical/bacteriological sample submitted to Department? Yes \_\_\_ No **X**

If yes, mo/day/yr sample was submitted \_\_\_\_\_

Water Well Disinfected: Yes \_\_\_ No **X**

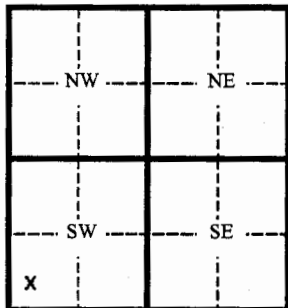

5 TYPE OF BLANK CASING USED:

- |              |            |                   |                 |                         |
|--------------|------------|-------------------|-----------------|-------------------------|
| 1 Steel      | 3 RMP (SR) | 5 Wrought         | 7 Fiberglass    | 9 Other (specify below) |
| <b>2 PVC</b> | 4 ABC      | 6 Asbestos-Cement | 8 Concrete Tile |                         |
- Blank casing diameter 2 in. Was casing pulled? Yes \_\_\_ No **X** If yes, how much \_\_\_\_\_

Casing height above or **below land surface** 240 in. Overdrilled to 20 feet below ground surface (bgs)

6 GROUT PLUG MATERIAL: 1 Neat cement 2 Cement grout **3 Bentonite** 4 Other \_\_\_\_\_

Grout Plug Intervals From 3 ft. to 50.06 ft. From \_\_\_\_\_ ft. to \_\_\_\_\_ ft. From \_\_\_\_\_ ft. to \_\_\_\_\_ ft.

What is the nearest source of possible contamination:

- |                          |                   |                         |                          |
|--------------------------|-------------------|-------------------------|--------------------------|
| 1 Septic tank            | 6 Seepage pit     | 11 Fuel storage         | 16 Other (specify below) |
| 2 Sewer lines            | 7 Pit privy       | 12 Fertilizer storage   |                          |
| 3 Watertight sewer lines | 8 Sewage lagoon   | 13 Insecticide storage  |                          |
| 4 Lateral lines          | 9 Feedyard        | 14 Abandoned water well |                          |
| 5 Cess Pool              | 10 Livestock pens | 15 Oil well/ Gas well   |                          |

Direction from well? \_\_\_\_\_ How many feet? \_\_\_\_\_

FROM	TO	CODE	PLUGGING MATERIALS
0	3		Soil
3	50.06		Bentonite

7 CONTRACTOR'S OR LANDOWNER'S CERTIFICATION: This water well was plugged under my jurisdiction and was completed on (mo/day/yr) 9-6-05 and this record is true to the best of my knowledge and belief. Kansas Water Well Contractor's License No. 531 This Water Well Record was completed on (mo/day/yr) 9-20-05 under the business name of Geotechnical Services, Inc.  
 by (signature) *Walter A. ...*

INSTRUCTIONS: Please fill in blanks and circle the correct answers. Send three copies to Kansas Department of Health and Environment, Bureau of Water, 1000 S W Jackson St., Ste. 420, Topeka, Kansas 66620-0001. Telephone: 785-296-3565. Send one to Water Well Owner and retain one for your records.