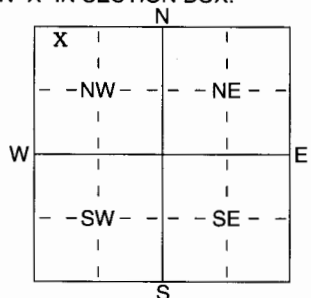


1 LOCATION OF WATER WELL: Fraction NW 1/4 NW 1/4 NW 1/4 Section Number 34 Township Number T 13 S Range Number R 18 E
 County: Ellis

Distance and direction from nearest town or city street address of well if located within city?
2601 Vine Hays Kansas

2 WATER WELL OWNER: KDHE-BER
 RR#, St. Address, Box # : 1000 SW Jackson Suite 400 Board of Agriculture, Division of Water Resources
 City, State, ZIP Code : Topeka, KS 66610 Application Number: AS-2

3 LOCATE WELL'S LOCATION WITH AN "X" IN SECTION BOX:

 4 DEPTH OF COMPLETED WELL 68 ft. ELEVATION: 2037.49
 Depth(s) Groundwater Encountered 1 ft. 2 ft. 3 ft.
 WELL'S STATIC WATER LEVEL 55.18 ft. below land surface measured on mo/day/yr 06-02-05
 Pump test data: Well water was ft. after hours pumping gpm
 Est. Yield gpm: Well water was ft. after hours pumping gpm
 WELL WATER TO BE USED AS: 5 Public water supply 8 Air conditioning 11 Injection well
 1 Domestic 3 Feedlot 6 Oil field water supply 9 Dewatering 12 Other (Specify below)
 2 Irrigation 4 Industrial 7 Domestic (lawn & garden) Monitoring well AS-2

5 TYPE OF BLANK CASING USED: 1 Steel 3 RMP (SR) 5 Wrought iron 8 Concrete tile CASING JOINTS: Glued Clamped
 PVC 4 ABS 6 Asbestos-Cement 9 Other (specify below) Welded
 7 Fiberglass Threaded X
 Blank casing diameter 2 in. to 64 ft. Dia in. to ft. Dia in. to ft.
 Casing height above land surface 0 in., weight 0.70 lbs./ft. Wall thickness or guage No. 0.154
 TYPE OF SCREEN OR PERFORATION MATERIAL: PVC 10 Asbestos-Cement
 1 Steel 3 Stainless Steel 5 Fiberglass 8 RMP (SR) 11 Other (Specify)
 2 Brass 4 Galvanized Steel 6 Concrete tile 9 ABS 12 None used (open hole)
 SCREEN OR PERFORATION OPENINGS ARE: 5 Guazed wrapped 8 Saw cut 11 None (open hole)
 1 Continuous slot Mill slot 0.020 6 Wire wrapped 9 Drilled holes
 2 Louvered shutter 4 Key punched 7 Torch cut 10 Other (specify) ft.
 SCREEN-PERFORATED INTERVALS: From 64 ft. to 68 ft. From ft. to ft.
 GRAVEL PACK INTERVALS: From ft. to ft. From ft. to ft.

6 GROUT MATERIAL: 1 Neat cement Cement grout Bentonite 4 Other
 Grout Intervals: From 0 ft. to 2 ft., From 2 ft. to 64 ft., From ft. to ft.
 What is the nearest source of possible contamination:
 1 Septic tank 4 Lateral lines 7 Pit privy 10 Livestock pens 14 Abandoned water well
 2 Sewer lines 5 Cess pool 8 Sewage lagoon 11 Fuel storage 15 Oil well/Gas well
 3 Watertight sewer lines 6 Seepage pit 9 Feedyard 12 Fertilizer storage 16 Other (specify below)
contaminated site
 Direction from well? How many feet?

| FROM | TO | LITHOLOGIC LOG | FROM | TO | PLUGGING INTERVALS |
|------|----|----------------------------|------|----|--------------------|
| 0 | .5 | Asphalt | | | |
| .5 | 4 | Clay, dk brown-black | | | |
| 4 | 13 | Silt, with clay | | | |
| 13 | 40 | Silt, lt brown, with clay | | | |
| 40 | 50 | Silt, lt brown | | | |
| 50 | 62 | Silt, lt brown | | | |
| 62 | 66 | Caliche rubble zone w/silt | | | |
| 66 | 68 | Silt w/clay | | | |

7 CONTRACTOR'S OR LANDOWNER'S CERTIFICATION: This water well was (1) constructed, (2) reconstructed, or (3) plugged under my jurisdiction and was completed on (mo/day/year) 06-02-05 and this record is true to the best of my knowledge and belief. Kansas Water Well Contractor's Licence No 554 This Water Well Record was completed on (mo/day/yr) 10-5-05 under the business name of Woofter Pump & Well, Inc by (signature) Jay Woofter (ccc)