


|         |                         |                       |                |                 |  |
|---------|-------------------------|-----------------------|----------------|-----------------|--|
| 1       | LOCATION OF WATER WELL: | Fraction              | Section Number | Township Number | Range Number   |
| County: | <u>Ellis</u>            | <u>NW ¼ SW ¼ SW ¼</u> | <u>15</u>      | <u>13 S</u>     | <u>18</u> <span style="border: 1px solid black; border-radius: 50%; padding: 2px;">EW</span> |

Distance and direction from nearest town or city street address of well if located within city?  
5800 N. Vine, Hays

|   |                           |                       |   |
|---|---------------------------|-----------------------|---|
| 2 | WATER WELL OWNER:         | <u>Errol Engel</u>    | Board of Agriculture, Division of Water Resources |
|   | RR #, St. Address, Box #: | <u>5800 N. Vine</u>   | Application Number:                               |
|   | City, State, ZIP Code :   | <u>Hays, KS 67601</u> |   |

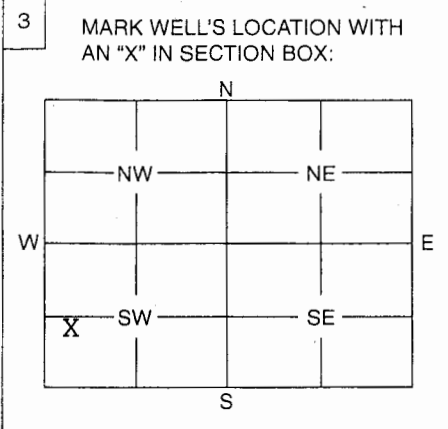

|              |  |  |                       |              |              |                          |  |           |                            |                   |              |                    |                |
|--------------|--|--|-----------------------|--------------|--------------|--------------------------|--|-----------|----------------------------|-------------------|--------------|--------------------|----------------|
| 4            | DEPTH OF WELL <u>24.5</u> ft.  |  |                       |              |              |                          |  |           |                            |                   |              |                    |                |
|              | WELL'S STATIC WATER LEVEL <u>18.49</u> ft.   |  |                       |              |              |                          |  |           |                            |                   |              |                    |                |
|              | WELL WAS USED AS:  |  |                       |              |              |                          |  |           |                            |                   |              |                    |                |
|              | <table border="0"> <tr> <td>1 Domestic</td> <td>5 Public Water Supply</td> <td>9 Dewatering</td> </tr> <tr> <td>2 Irrigation</td> <td>6 Oil Field Water Supply</td> <td><span style="border: 1px solid black; border-radius: 50%; padding: 2px;">10</span> Monitoring Well</td> </tr> <tr> <td>3 Feedlot</td> <td>7 Domestic (Lawn &amp; Garden)</td> <td>11 Injection Well</td> </tr> <tr> <td>4 Industrial</td> <td>8 Air Conditioning</td> <td>12 Other .....</td> </tr> </table> | 1 Domestic   | 5 Public Water Supply | 9 Dewatering | 2 Irrigation | 6 Oil Field Water Supply | <span style="border: 1px solid black; border-radius: 50%; padding: 2px;">10</span> Monitoring Well | 3 Feedlot | 7 Domestic (Lawn & Garden) | 11 Injection Well | 4 Industrial | 8 Air Conditioning | 12 Other ..... |
| 1 Domestic   | 5 Public Water Supply  | 9 Dewatering   |                       |              |              |                          |  |           |                            |                   |              |                    |                |
| 2 Irrigation | 6 Oil Field Water Supply   | <span style="border: 1px solid black; border-radius: 50%; padding: 2px;">10</span> Monitoring Well |                       |              |              |                          |  |           |                            |                   |              |                    |                |
| 3 Feedlot    | 7 Domestic (Lawn & Garden)   | 11 Injection Well  |                       |              |              |                          |  |           |                            |                   |              |                    |                |
| 4 Industrial | 8 Air Conditioning   | 12 Other .....   |                       |              |              |                          |  |           |                            |                   |              |                    |                |
|              | Was a chemical / bacteriological sample submitted to Department? Yes ..... No <span style="border: 1px solid black; border-radius: 50%; padding: 2px;">X</span> .....  |  |                       |              |              |                          |  |           |                            |                   |              |                    |                |
|              | If yes, mo/day/yr sample was submitted .....   |  |                       |              |              |                          |  |           |                            |                   |              |                    |                |
|              | Water Well Disinfected: Yes ..... No <span style="border: 1px solid black; border-radius: 50%; padding: 2px;">X</span> .....   |  |                       |              |              |                          |  |           |                            |                   |              |                    |                |

|   |   |                   |                 |                         |              |                         |   |       |                   |                 |       |
|---|---|-------------------|-----------------|-------------------------|--------------|-------------------------|---|-------|-------------------|-----------------|-------|
| 5   | TYPE OF BLANK CASING USED:  |                   |                 |                         |              |                         |   |       |                   |                 |       |
|   | <table border="0"> <tr> <td>1 Steel</td> <td>3 RMP (SR)</td> <td>5 Wrought</td> <td>7 Fiberglass</td> <td>9 Other (Specify below)</td> </tr> <tr> <td><span style="border: 1px solid black; border-radius: 50%; padding: 2px;">2</span> PVC</td> <td>4 ABS</td> <td>6 Asbestos-Cement</td> <td>8 Concrete Tile</td> <td>.....</td> </tr> </table> | 1 Steel           | 3 RMP (SR)      | 5 Wrought               | 7 Fiberglass | 9 Other (Specify below) | <span style="border: 1px solid black; border-radius: 50%; padding: 2px;">2</span> PVC | 4 ABS | 6 Asbestos-Cement | 8 Concrete Tile | ..... |
| 1 Steel   | 3 RMP (SR)  | 5 Wrought         | 7 Fiberglass    | 9 Other (Specify below) |              |                         |   |       |                   |                 |       |
| <span style="border: 1px solid black; border-radius: 50%; padding: 2px;">2</span> PVC | 4 ABS   | 6 Asbestos-Cement | 8 Concrete Tile | .....                   |              |                         |   |       |                   |                 |       |
|   | Blank casing diameter <u>2</u> in. Was casing pulled? Yes <span style="border: 1px solid black; border-radius: 50%; padding: 2px;">X</span> ..... No ..... If yes, how much <u>25'</u> .....  |                   |                 |                         |              |                         |   |       |                   |                 |       |
|   | Casing height above or below land surface <u>n/a</u> in.  |                   |                 |                         |              |                         |   |       |                   |                 |       |

|                          |  
|--------------------------|--|------------------------------------|--|---|--|---------------|-------------|-----------------------|------------------|--------------------------|-----------------|------------------------|--|-----------------|------------|-------------------------|--|-------------|-------------------|----------------------|--|
| 6                        | GROUT PLUG MATERIAL:   | 1 Neat cement                      | 2 Cement grout   | <span style="border: 1px solid black; border-radius: 50%; padding: 2px;">3</span> Bentonite | <span style="border: 1px solid black; border-radius: 50%; padding: 2px;">4</span> Other <u>Native soil</u> ..... |               |             |                       |                  |                          |                 |                        |  |                 |            |                         |  |             |                   |                      |  |
|                          | Grout Plug Intervals:  | From <u>0</u> ft. to <u>3</u> ft., | From <u>3</u> ft. to <u>24.5</u> ft.,  | From ..... to ..... ft.   |  |               |             |                       |                  |                          |                 |                        |  |                 |            |                         |  |             |                   |                      |  |
|                          | What is the nearest source of possible contamination:  |                                    |  
|                          | <table border="0"> <tr> <td>1 Septic tank</td> <td>6 Seepage pit</td> <td>11 Fuel storage</td> <td><span style="border: 1px solid black; border-radius: 50%; padding: 2px;">16</span> Other (specify below)</td> </tr> <tr> <td>2 Sewer lines</td> <td>7 Pit privy</td> <td>12 Fertilizer storage</td> <td><u>AST</u>.....</td> </tr> <tr> <td>3 Watertight sewer lines</td> <td>8 Sewage lagoon</td> <td>13 Insecticide storage</td> <td></td> </tr> <tr> <td>4 Lateral lines</td> <td>9 Feedyard</td> <td>14 Abandoned water well</td> <td></td> </tr> <tr> <td>5 Cess pool</td> <td>10 Livestock pens</td> <td>15 Oil well/Gas well</td> <td></td> </tr> </table> | 1 Septic tank                      | 6 Seepage pit  | 11 Fuel storage   | <span style="border: 1px solid black; border-radius: 50%; padding: 2px;">16</span> Other (specify below)         | 2 Sewer lines | 7 Pit privy | 12 Fertilizer storage | <u>AST</u> ..... | 3 Watertight sewer lines | 8 Sewage lagoon | 13 Insecticide storage |  | 4 Lateral lines | 9 Feedyard | 14 Abandoned water well |  | 5 Cess pool | 10 Livestock pens | 15 Oil well/Gas well |  |
| 1 Septic tank            | 6 Seepage pit  | 11 Fuel storage                    | <span style="border: 1px solid black; border-radius: 50%; padding: 2px;">16</span> Other (specify below) |   |  |               |             |                       |                  |                          |                 |                        |  |                 |            |                         |  |             |                   |                      |  |
| 2 Sewer lines            | 7 Pit privy  | 12 Fertilizer storage              | <u>AST</u> .....   |   |  |               |             |                       |                  |                          |                 |                        |  |                 |            |                         |  |             |                   |                      |  |
| 3 Watertight sewer lines | 8 Sewage lagoon  | 13 Insecticide storage             |  |   |  |               |             |                       |                  |                          |                 |                        |  |                 |            |                         |  |             |                   |                      |  |
| 4 Lateral lines          | 9 Feedyard   | 14 Abandoned water well            |  |   |  |               |             |                       |                  |                          |                 |                        |  |                 |            |                         |  |             |                   |                      |  |
| 5 Cess pool              | 10 Livestock pens  | 15 Oil well/Gas well               |  |   |  |               |             |                       |                  |                          |                 |                        |  |                 |            |                         |  |             |                   |                      |  |
|                          | Direction from well? .....   | How many feet? .....               |  |   |  |               |             |                       |                  |                          |                 |                        |  |                 |            |                         |  |             |                   |                      |  |

| FROM | TO          | PLUGGING MATERIALS |
|------|-------------|--------------------|
| 0    | 3           | Native soil        |
| 3    | 20          | Bentonite (8")     |
| 20   | <u>24.5</u> | Bentonite (2")     |
|      |             |                    |
|      |             |                    |
|      |             |                    |
|      |             |                    |

MW 1  
 KDHE #A6 026 40205  
 GeoCore #1250

|   |   |
|---|---|
| 7 | CONTRACTOR'S OF LANDOWNER'S CERTIFICATION: This water well was plugged under my jurisdiction and was completed on (mo/day/year) <u>11/1/2005</u> and this record is true to the best of my knowledge and belief. Kansas Water Well Contractor's License No. <u>527</u> . This Water Well Record was completed on (mo/day/year) <u>11/9/2005</u> under the business name of <u>GeoCore, Inc.</u> by (signature) <u>[Signature]</u> |
|---|---|

INSTRUCTIONS: Use typewriter or ball point pen. Please press firmly and print clearly. Please fill in blanks, underline or circle the correct answers. Send top three copies to Kansas Department of Health and Environment, Bureau of Water, Geology Section, 1000 SW Jackson St., Ste. 420, Topeka, Kansas 66612-1367. Telephone: 785/296-5522. Send one to Water Well Owner and retain one for your records.