


1 LOCATION OF WATER WELL: County: <b>Ellis</b>	Fraction <b>SW ¼ SW ¼ SW ¼</b>	Section Number <b>28</b>	Township Number T <b>13</b> S	Range Number R <b>18</b> W
---	-----------------------------------	-----------------------------	----------------------------------	-------------------------------

Distance and direction from nearest town or city street address of well if located within city?  
**501 W. 27<sup>th</sup> Street, Hays**

2 WATER WELL OWNER: RR#, St. Address, Box # : City, State, ZIP Code :	<b>Coastal Mart #2502</b> <b>9 Greenway Plaza</b> <b>Houston, TX 77046</b>	Board of Agriculture, Division of Water Resources Application Number:
---	--	--

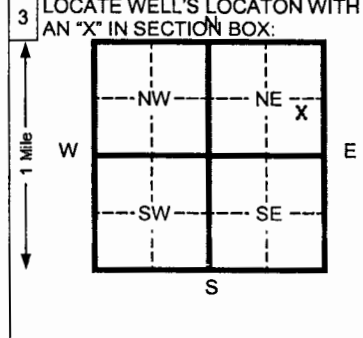

4 DEPTH OF COMPLETED WELL: <b>50</b> ft. ELEVATION:
Depth(s) Groundwater Encountered 1 <b>48</b> ft. 2 _____ ft. 3 _____ ft.
WELL'S STATIC WATER LEVEL _____ ft. below land surface measured on mo/day/yr
Pump test data: Well water was _____ ft. after _____ hours pumping _____ gpm
Est. Yield _____ gpm: Well water was _____ ft. after _____ hours pumping _____ gpm
Bore Hole Diameter <b>12.5</b> in. to <b>50</b> ft. and _____ in. to _____ ft.
WELL WATER TO BE USED AS: 5 Public water supply 8 Air conditioning 11 Injection well
1 Domestic 3 Feed lot 6 Oil field water supply 9 Dewatering 12 Other (Specify below)
2 Irrigation 4 Industrial 7 Lawn and garden (domestic) 10 Monitoring well <b>Observation Well</b>
Was a chemical/bacteriological sample submitted to Department? Yes _____ No <b>X</b> If yes, mo/day/yr sample was submitted
Water Well Disinfected? Yes _____ No <b>X</b>

5 TYPE OF BLANK CASING USED:	5 Wrought Iron	8 Concrete tile	CASING JOINTS: Glued _____ Clamped _____
1 Steel	3 RMP (SR)	6 Asbestos-Cement	9 Other (specify below)
<b>2 PVC</b>	4 ABS	7 Fiberglass	_____
Blank casing diameter <b>4</b> in. to <b>20</b> ft. Dia _____ in. to _____ ft. Dia _____ in. to _____ ft.			
Casing height above land surface <b>Flushmount</b> in., weight <b>2.0</b> lbs./ft. Wall thickness or gauge No. <b>Sch. 40</b>			
TYPE OF SCREEN OR PERFORATION MATERIAL:	<b>7 PVC</b>	10 Asbestos-cement	
1 Steel	3 Stainless steel	5 Fiberglass	8 RMP (SR)
2 Brass	4 Galvanized steel	6 Concrete tile	9 ABS
SCREEN OR PERFORATION OPENINGS ARE:	5 Gauzed wrapped	8 Saw cut	11 None (open hole)
1 Continuous slot	<b>3 Mill slot</b>	6 Wire wrapped	9 Drilled holes
2 Louvered shutter	4 Key punched	7 Torch cut	10 Other (specify) _____
SCREEN-PERFORATED INTERVALS: From <b>20</b> ft. to <b>50</b> ft. From _____ ft. to _____ ft.			
GRAVEL PACK INTERVALS: From <b>18</b> ft. to <b>50</b> ft. From _____ ft. to _____ ft.			

6 GROUT MATERIAL:	1 Neat cement	<b>2 Cement grout</b>	<b>3 Bentonite</b>	4 Other _____
Grout Intervals From <b>0.5</b> ft. to <b>14</b> ft. From <b>14</b> ft. to <b>18</b> ft. From _____ ft. to _____ ft.				
What is the nearest source of possible contamination:	1 Septic tank	4 Lateral lines	7 Pit privy	10 Livestock pens
	2 Sewer lines	5 Cess pool	8 Sewage lagoon	11 Fuel storage
	3 Watertight sewer lines	6 Seepage pit	9 Feedyard	12 Fertilizer storage
				13 Insecticide storage
				14 Abandoned water well
				15 Oil well/ Gas well
				16 Other (specify below)
Direction from well? _____				How many feet? _____

FROM	TO	CODE	LITHOLOGIC LOG	FROM	TO	PLUGGING INTERVALS
0	0.5		Asphalt			
0.5	5		Clay			
5	21		Silty Clay			
21	35		Clayey Sand			
35	50		Sand			

7 CONTRACTOR'S OR LANDOWNER'S CERTIFICATION: This water well was <b>(1) constructed</b> , (2) reconstructed, or (3) plugged under my jurisdiction and was completed on (mo/day/yr) <b>10-26-05</b> and this record is true to the best of my knowledge and belief, Kansas Water Well Contractor's License No. <b>531</b> This Water Well Record was completed on (mo/day/yr) <b>11-30-05</b> under the business name of <b>Geotechnical Services, Inc.</b> by (signature) <i>[Signature]</i>
--