

CORRECTED

WATER WELL PLUGGING RECORD

Form WWC-5P

KSA 82a-1212

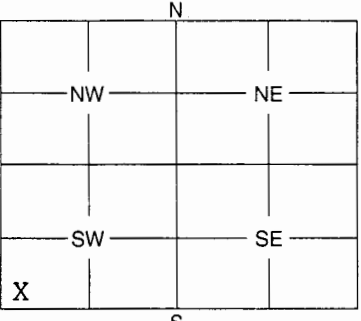
ID NO.

00162090

1	LOCATION OF WATER WELL:	Fraction	Section Number	Township Number	Range Number
	County: Ellis	SW ¹ / ₄ SW ¹ / ₄ SW ¹ / ₄	33	13	18 E/W

Distance and direction from nearest town or city street address of well if located within city?
335 W. 8th, Hays

2	WATER WELL OWNER: Mr. Quick Mini Mart P.O. Box 1036 RR #, St. Address, Box #: Hays, KS 67601 City, State, ZIP Code :	Board of Agriculture, Division of Water Resources Application Number:
---	--	--

3	MARK WELL'S LOCATION WITH AN "X" IN SECTION BOX: 	4	DEPTH OF WELL 20 ft. WELL'S STATIC WATER LEVEL 16.52 ft. WELL WAS USED AS: 1 Domestic 5 Public Water Supply 9 Dewatering 2 Irrigation 6 Oil Field Water Supply 10 Monitoring Well 3 Feedlot 7 Domestic (Lawn & Garden) 11 Injection Well 4 Industrial 8 Air Conditioning 12 Other
---	---	---	--

Was a chemical / bacteriological sample submitted to Department? Yes No **X**.....
If yes, mo/day/yr sample was submitted

Water Well Disinfected: Yes No **X**.....

5	TYPE OF BLANK CASING USED: 1 Steel 3 RMP (SR) 5 Wrought 7 Fiberglass 9 Other (Specify below) 2 PVC 4 ABS 6 Asbestos-Cement 8 Concrete Tile
---	---

Blank casing diameter**2**..... in. Was casing pulled? Yes **X**..... No If yes, how much**10'**.....
Casing height above or below land surface**n/a**..... in.

6	GROUT PLUG MATERIAL: 1 Neat cement 2 Cement grout 3 Bentonite 4 Other Native soil
---	--

Grout Plug Intervals: From**0**..... ft. to**2**..... ft., From**2**..... ft. to**20**..... ft., From to ft.

What is the nearest source of possible contamination:
1 Septic tank 6 Seepage pit 11 Fuel storage 16 Other (specify below)
2 Sewer lines 7 Pit privy 12 Fertilizer storage

Direction from well? How many feet?

FROM	TO	PLUGGING MATERIALS
0	2	Native soil
2	25	Bentonite (8")

MW12
GeoCore #382
KDHE #U6 026 00754

7	CONTRACTOR'S OF LANDOWNER'S CERTIFICATION: This water well was plugged under my jurisdiction and was completed on (mo/day/year) 1-31-2006 and this record is true to the best of my knowledge and belief. Kansas Water Well Contractor's License No. 527 This Water Well Record was completed on (mo/day/year) 2-1-2006 under the business name of GeoCore Inc. by (signature) <i>Don Kell</i>
---	--

INSTRUCTIONS: Use typewriter or ball point pen. Please press firmly and print clearly. Please fill in blanks, underline or circle the correct answers. Send top three copies to Kansas Department of Health and Environment, Bureau of Water, Geology Section, 1000 SW Jackson St., Ste. 420, Topeka, Kansas 66612-1367. Telephone: 785/296-5522. Send one to Water Well Owner and retain one for your records.