


MW-6

1	LOCATION OF WATER WELL: County: <u>ELLIS</u>	Fraction <u>SW 1/4 NW 1/4 SE 1/4</u>	Section Number <u>32</u>	Township Number <u>13 S</u>	Range Number <u>18 W</u>
---	---	---	-----------------------------	--------------------------------	-----------------------------

Distance and direction from nearest town or city street address of well if located within city?
FHSU Motor Pool

2	WATER WELL OWNER: <u>FORT HAYS STATE UNIVERSITY (FHSU) MOTORPOOL</u> RR #, St. Address, Box #: <u>N. CAMPUS DRIVE, Bldg 222</u> City, State, ZIP Code: <u>HAYS, KS 67601</u>	Board of Agriculture, Division of Water Resources Application Number:
---	--	--

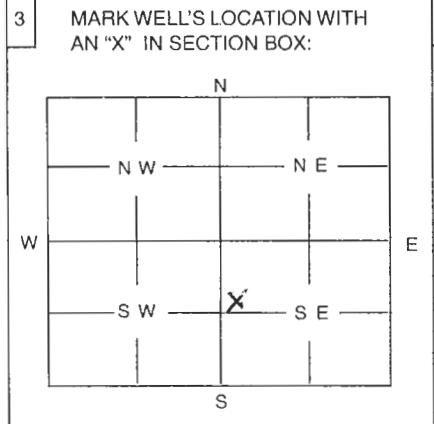

4	DEPTH OF WELL <u>21</u> ft	<u>MW-6</u> <u>KDHE Project Code: 460260756</u>
	WELL'S STATIC WATER LEVEL <u>17 1/2</u> ft.	
WELL WAS USED AS:		
1 Domestic	5 Public Water Supply	9 Dewatering
2 Irrigation	6 Oil Field Water Supply	<u>10</u> Monitoring Well
3 Feedlot	7 Domestic (Lawn & Garden)	11 Injection Well
4 Industrial	8 Air Conditioning	12 Other
Was a chemical / bacteriological sample submitted to Department? Yes <input checked="" type="checkbox"/> No		
If yes, mo/day/yr sample was submitted <u>2-5-07 (VOCs)</u>		
Water Well Disinfected: Yes No <input checked="" type="checkbox"/>		

5 TYPE OF BLANK CASING USED:

1 Steel	3 RMP (SR)	5 Wrought	7 Fiberglass	9 Other (Specify below)
<u>2 PVC</u>	4 ABS	6 Asbestos-Cement	8 Concrete Tile	

Blank casing diameter 2 in. Was casing pulled? Yes No

Casing height above or below land surface pulled in. If yes, how much 21' (all)

6 GROUT PLUG MATERIAL: 1 Neat cement 2 Cement grout 3 Bentonite 4 Other

Grout Plug Intervals: From 21 ft. to 12 ft., From 12 ft. to ft., From to ft.

What is the nearest source of possible contamination:

1 Septic tank	6 Seepage pit	<u>11 Fuel storage</u>	16 Other (specify below)
2 Sewer lines	7 Pit privy	12 Fertilizer storage	
3 Watertight sewer lines	8 Sewage lagoon	13 Insecticide storage	
4 Lateral lines	9 Feedyard	14 Abandoned water well	
5 Cess Pool	10 Livestock pens	15 Oil well/Gas well	

Direction from well? South How many feet? 2

FROM	TO	PLUGGING MATERIALS
<u>21'</u>	<u>12'</u>	<u>1/2-inch bentonite chips</u>
<u>12'</u>	<u>0'</u>	<u>UST basin (sand + UST) + concrete.</u>

★ NOTE: MW-6 was located within the new excavation/tank basin dug. Casing and screen were pulled and the resulting shaft poured full of bentonite. The UST basin construction then continued. The pit/basin was backfilled w/ sand after the UST was installed.

7 CONTRACTOR'S OR LANDOWNER'S CERTIFICATION: This water well was plugged under my jurisdiction and was completed on (mo/day/year) 7-24-07 and this record is true to the best of my knowledge and belief. Kansas Water Well Contractor's License No. KDHE This Water Well Record was completed on (mo/day/year) 7-24-07 under the business name of KDHE - NWRO, HAYS by (signature) William H. Johnson

INSTRUCTIONS: Use typewriter or ball point pen. Please press firmly and print clearly. Please fill in blanks, underline or circle the correct answers. Send top three copies to Kansas Department of Health and Environment, Bureau of Water, Topeka, Kansas 66620-0001. Telephone: 785/296-3565. Send one to Water Well Owner and retain one for your records.