


1	LOCATION OF WATER WELL: County: <u>ELLIS</u>	Fraction <u>NW¹/₄ NW¹/₄ NW¹/₄</u>	Section Number <u>27</u>	Township Number <u>13 S</u>	Range Number <u>18 W</u>
---	---	--	-----------------------------	--------------------------------	-----------------------------

Distance and direction from nearest town or city street address of well if located within city?
I-70 West bound off ramp; KDOT R-O-W just E. of US Hwy 283/VINE ST.

2	WATER WELL OWNER: <u>RITA PFEIFER</u> RR #, St. Address, Box #: <u>245 E 41st</u> City, State, ZIP Code: <u>HAYS KS 67601</u>	MW-10 Board of Agriculture, Division of Water Resources Application Number:
---	---	---

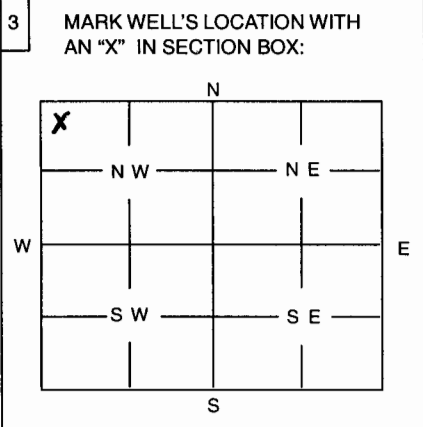

4 DEPTH OF WELL 30 ft
WELL'S STATIC WATER LEVEL 18 ft

WELL WAS USED AS:

1 Domestic	5 Public Water Supply	9 Dewatering
2 Irrigation	6 Oil Field Water Supply	<u>10</u> Monitoring Well
3 Feedlot	7 Domestic (Lawn & Garden)	11 Injection Well
4 Industrial	8 Air Conditioning	12 Other

Was a chemical / bacteriological sample submitted to Department? Yes No

If yes, mo/day/yr sample was submitted

Water Well Disinfected: Yes No

5 TYPE OF BLANK CASING USED:

1 Steel	3 RMP (SR)	5 Wrought	7 Fiberglass	9 Other (Specify below)
<u>2 PVC</u>	4 ABS	6 Asbestos-Cement	8 Concrete Tile	

Blank casing diameter 2 in. Was casing pulled? Yes No If yes, how much

Casing height above or below land surface 6 inches in. ~36" of casing was chopped off with backhoe after plug.

6 GROUT PLUG MATERIAL: 1 Neat cement 2 Cement grout 3 Bentonite 4 Other 1/4-inch, washed, pea gravel 25-20' bgl.

Grout Plug Intervals: From 25 ft. to 20 ft., From 20 ft. to 2 ft., From to ft.

What is the nearest source of possible contamination:

1 Septic tank	6 Seepage pit	<u>11</u> Fuel storage	16 Other (specify below):
2 Sewer lines	7 Pit privy	12 Fertilizer storage	<u>I-70 bar ditch that</u>
3 Watertight sewer lines	8 Sewage lagoon	13 Insecticide storage	<u>collects highway Run-off.</u>
4 Lateral lines	9 Feedyard	14 Abandoned water well	
5 Cess Pool	10 Livestock pens	15 Oil well/Gas well	

Direction from well? North How many feet? ~150

FROM	TO	PLUGGING MATERIALS
25'	20'	1/4-inch pea gravel, washed
20	2'	Hook Plug bentonite clay (hydrated)

MW-10 was damaged by Vine St + I-70 W-bound off-ramp construction activities. Well found + properly P/A on 11/7/67.

7 CONTRACTOR'S OR LANDOWNER'S CERTIFICATION: This water well was plugged under my jurisdiction and was completed on (mo/day/year) 11-13-07 and this record is true to the best of my knowledge and belief. Kansas Water Well Contractor's License No. KDHE - BEFS This Water Well Record was completed on (mo/day/year) 11-13-07 under the business name of KDHE - NWSD by (signature) Bill Pfeifer, Prof. Geologist III #390

INSTRUCTIONS: Use typewriter or ball point pen. Please press firmly and print clearly. Please fill in blanks, underline or circle the correct answers. Send top three copies to Kansas Department of Health and Environment, Bureau of Water, Topeka, Kansas 66620-0001. Telephone: 785/296-3565. Send one to Water Well Owner and retain one for your records.