


1 LOCATION OF WATER WELL: Fraction Section Number Township Number Range Number
 County: ELLIS NW 1/4 NW 1/4 NW 1/4 27 13 S 18 W

Distance and direction from nearest town or city street address of well if located within city?
I-70 West bound off ramp; KDOT R-0-W just E. of US Hwy 183/Vinc St.

2 WATER WELL OWNER: RITA PFEIFER mw-11
 RR #, St. Address, Box #: 245 E. 41st
 City, State, ZIP Code: HAYS KS 67601
 Board of Agriculture, Division of Water Resources
 Application Number:

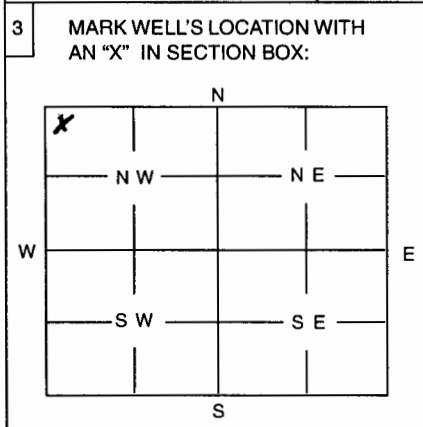

4 DEPTH OF WELL 25 ft
 WELL'S STATIC WATER LEVEL 20.3 ft
 WELL WAS USED AS:
 1 Domestic 2 Irrigation 3 Feedlot 4 Industrial 5 Public Water Supply 6 Oil Field Water Supply 7 Domestic (Lawn & Garden) 8 Air Conditioning 9 Dewatering 10 Monitoring Well 11 Injection Well 12 Other
 Was a chemical / bacteriological sample submitted to Department? Yes No
 If yes, mo/day/yr sample was submitted
 Water Well Disinfected: Yes No

5 TYPE OF BLANK CASING USED:
 1 Steel 2 PVC 3 RMP (SR) 4 ABS 5 Wrought 6 Asbestos-Cement 7 Fiberglass 8 Concrete Tile 9 Other (Specify below)
 Blank casing diameter 2 in. Was casing pulled? Yes No
 Casing height above or below land surface -6 inches in. ~36" of PVC casing was chopped off w/ backhoe after plugging.
 If yes, how much

6 GROUT PLUG MATERIAL: 1 Neat cement 2 Cement grout 3 Bentonite 4 Other 1/4-inch, washed, pea gravel
 Grout Plug Intervals: From 25 ft. to 20 ft., From 20 ft. to 2 ft., From to ft.
 What is the nearest source of possible contamination:
 1 Septic tank 2 Sewer lines 3 Watertight sewer lines 4 Lateral lines 5 Cess Pool 6 Seepage pit 7 Pit privy 8 Sewage lagoon 9 Feedyard 10 Livestock pens 11 Fuel storage 12 Fertilizer storage 13 Insecticide storage 14 Abandoned water well 15 Oil well/Gas well 16 Other (specify below) I-70 bar ditch that collects Hwy run-off.
 Direction from well? NW How many feet? ~350'

FROM	TO	PLUGGING MATERIALS
25	20	1/4-inch, washed, pea gravel
20	2	Hot-Plug Bentonite chips (hydrated)

MW-11 was damaged by Vinc St. + I-70 W-bound off-ramp construction activities. Well found + properly P/A on 11/7/07.

7 CONTRACTOR'S OR LANDOWNER'S CERTIFICATION: This water well was plugged under my jurisdiction and was completed on (mo/day/year) 11-7-07 and this record is true to the best of my knowledge and belief. Kansas Water Well Contractor's License No. KDHE - PER - BEFS This Water Well Record was completed on (mo/day/year) 11-13-07
 by (signature) Bell Heimer under the business name of KDHE NWDO Prof. Geologist III, #390

INSTRUCTIONS: Use typewriter or ball point pen. Please press firmly and print clearly. Please fill in blanks, underline or circle the correct answers. Send top three copies to Kansas Department of Health and Environment, Bureau of Water, Topeka, Kansas 66620-0001. Telephone: 785/296-3565. Send one to Water Well Owner and retain one for your records.