

WATER WELL RECORD


Form WWC-5

Division of Water Resources; App. No.

Well No 4

1 LOCATION OF WATER WELL: County: Ellis, Fraction 1/4 NE 1/4 NE 1/4, Section Number 34, Township Number T 13 S, Range Number R 18 E/W

2 WATER WELL OWNER: KDHE, RR#, St. Address, Box #: 1000 SW Jackson Suite 420, City, State, ZIP Code: Topeka, Ks. 66612

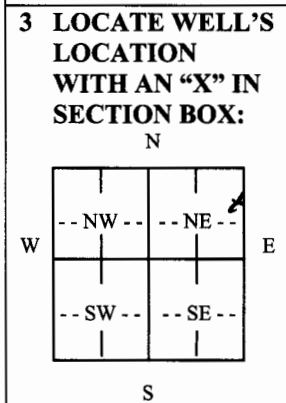

3 LOCATE WELL'S LOCATION WITH AN 'X' IN SECTION BOX: 4 DEPTH OF COMPLETED WELL 43 ft. Depth(s) Groundwater Encountered (1) 19 ft. (2) ... ft. (3) ... ft. WELL'S STATIC WATER LEVEL 19 ft. below land surface measured on mo/day/yr. Pump test data: Well water was ... ft. after ... hours pumping ... gpm. Est. Yield 150 gpm: Well water was ... ft. after ... hours pumping ... gpm. WELL WATER TO BE USED AS: 5 Public water supply, 8 Air conditioning, 11 Injection well, 1 Domestic, 3 Feedlot, 6 Oil field water supply, 9 Dewatering, 12 Other (Specify below), 2 Irrigation, 4 Industrial, 7 Domestic (lawn & garden), 10 Monitoring well. Was a chemical/bacteriological sample submitted to Department? Yes ... No [checked]; If yes, mo/day/yr Sample was submitted. Water well disinfected? Yes ... No [checked].

5 TYPE OF CASING USED: 1 Steel, 2 PVC, 3 RMP (SR), 4 ABS, 5 Wrought Iron, 6 Asbestos-Cement, 7 Fiberglass, 8 Concrete tile, 9 Other (specify below), CASING JOINTS: Glued [checked], Clamped, Welded, Threaded. Blank casing diameter 6 in. to 4.3 ft., Diameter. Casing height above land surface 1.8 in., Weight 160 lbs./ft., Wall thickness or gauge No. SDR 26. TYPE OF SCREEN OR PERFORATION MATERIAL: 1 Steel, 2 Brass, 3 Stainless Steel, 4 Galvanized Steel, 5 Fiberglass, 6 Concrete tile, 7 PVC, 8 RM (SR), 9 ABS, 10 Asbestos-Cement, 11 Other (Specify), 12 None used (open hole). SCREEN OR PERFORATION OPENINGS ARE: 1 Continuous slot, 2 Louvered shutter, 3 Mill slot, 4 Key punched, 5 Gauzed wrapped, 6 Wire wrapped, 7 Torch cut, 8 Saw Cut, 9 Drilled holes, 10 Other (specify), 11 None (open hole). SCREEN-PERFORATED INTERVALS: From 43 ft. to 33 ft., From ... ft. to ... ft. GRAVEL PACK INTERVALS: From 43 ft. to 30 ft., From ... ft. to ... ft.

6 GROUT MATERIAL: 1 Neat cement, 2 Cement grout, 3 Bentonite, 4 Other. Grout Intervals: From 0 ft. to 25 ft., From ... ft. to ... ft., From ... ft. to ... ft. What is the nearest source of possible contamination: 1 Septic tank, 2 Sewer lines, 3 Watertight sewer lines, 4 Lateral lines, 5 Cess pool, 6 Seepage pit, 7 Pit privy, 8 Sewage lagoon, 9 Feedyard, 10 Livestock pens, 11 Fuel storage, 12 Fertilizer Storage, 13 Insecticide Storage, 14 Abandoned water well, 15 Oil well/gas well, 16 Other (specify below). Direction from well? W, How many feet? 100.

Table with columns: FROM, TO, LITHOLOGIC LOG, FROM, TO, PLUGGING INTERVALS. Rows: 0 to 2 TOP SOIL, 2 to 31 CLAY, 31 to 41 SAND + GRAVEL, 41 to 43 SHALE.

7 CONTRACTOR'S OR LANDOWNER'S CERTIFICATION: This water well was (1) constructed, (2) reconstructed, or (3) plugged under my jurisdiction and was completed on (mo/day/year) 3/26/08... and this record is true to the best of my knowledge and belief. Kansas Water Well Contractor's License No. 478... This Water Well Record was completed on (mo/day/year) 3/26/08... under the business name of PRINCEWELL WATER WELL by (signature) [Handwritten Signature]

INSTRUCTIONS: Use typewriter or ball point pen. PLEASE PRESS FIRMLY and PRINT clearly. Please fill in blanks, underline or circle the correct answers. Send top three copies to Kansas Department of Health and Environment, Bureau of Water, Geology Section, 1000 SW Jackson St., Suite 420, Topeka, Kansas 66612-1367. Telephone 785-296-5522. Send one to WATER WELL OWNER and retain one for your records. Fee of \$5.00 for each constructed well. Visit us at http://www.kdheks.gov/waterwell/index.html.