

WATER WELL RECORD Form WWC-5 KSA 82a-1212

1 LOCATION OF WATER WELL: Fraction SW 1/4 SW 1/4 NW 1/4 Section Number 22 Township Number T 13 S Range Number R 18 E/W

Distance and direction from nearest town or city street address of well if located within city? 4820 N. Vine St., Hays

2 WATER WELL OWNER: Carrico Colorado LLC


RR#, St. Address, Box #: 3160 US Hwy 24

Board of Agriculture, Division of Water Resources

City, State, ZIP Code: Beloit, Kansas 67420

Application Number:

3 LOCATE WELL'S LOCATION WITH AN 'X' IN SECTION BOX:

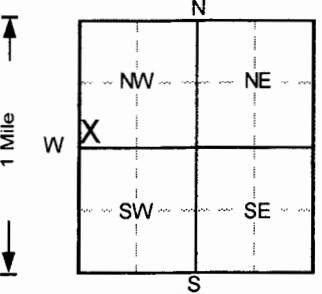

4 DEPTH OF COMPLETED WELL: 24 ft. ELEVATION: 2076.39. Includes groundwater depth, static water level, pump test data, and casing types.

5 TYPE OF BLANK CASING USED: 2 PVC. Casing diameter: 2 in. Dia: 14 ft. Casing height: -3.96 in. Includes screen and perforation details.

6 GROUT MATERIAL: 2 Cement grout, 3 Bentonite. Grout intervals: 0 to 2 ft. 2 to 12 ft. Includes contamination sources and well direction.

LITHOLOGIC LOG and PLUGGING INTERVALS table with columns FROM, TO, and descriptions of well layers and plugging points.

7 CONTRACTOR'S OR LANDOWNER'S CERTIFICATION: This water well was (1) constructed... 8/26/2009... This Water Well Record was completed on 9/15/2009... GeoCore, Inc.

OFFICE USE ONLY (vertical text on the right margin)

INSTRUCTIONS: Use typewriter or ball point pen. PLEASE PRESS FIRMLY and PRINT clearly. Please fill in blanks, underline or circle the correct answers.