


WATER WELL RECORD Form WWC-5 KSA 82a-1212

1 LOCATION OF WATER WELL: County: ELLIS Fraction: NE 1/4 SW 1/4 SW 1/4 Section Number: 21 Township Number: T 13 S Range Number: R 18 EW

Distance and direction from nearest town or city street address of well if located within city?
1316 W 42nd St HAYS KS

2 WATER WELL OWNER: NORMAN KELLER RR#, St. Address, Box #: 1316 W 42nd St Board of Agriculture, Division of Water Resources City, State, ZIP Code: HAYS KS 67601 Application Number:

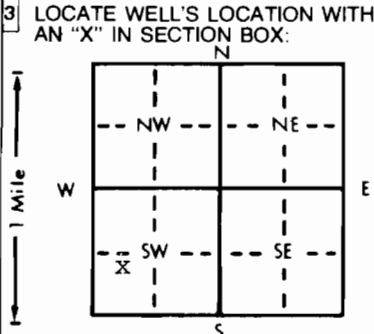

4 DEPTH OF COMPLETED WELL: 70 ft. ELEVATION: 55 ft. WELL'S STATIC WATER LEVEL: 55 ft. below land surface measured on mo/day/yr: 7-1-98

Depth(s) Groundwater Encountered: 1. 55 ft. 2. ft. 3. ft.

Pump test data: Well water was ft. after hours pumping gpm
Est. Yield .15 gpm: Well water was ft. after hours pumping gpm
Bore Hole Diameter: 10 in. to 70 ft., and in. to ft.

WELL WATER TO BE USED AS:
1 Domestic 3 Feedlot 6 Oil field water supply 9 Dewatering 12 Other (Specify below)
2 Irrigation 4 Industrial XX Lawn and garden only 10 Monitoring well

Was a chemical/bacteriological sample submitted to Department? Yes No XX; If yes, mo/day/yr sample was submitted

Water Well Disinfected? Yes No XX

5 TYPE OF BLANK CASING USED:
1 Steel 3 RMP (SR) 5 Wrought iron 8 Concrete tile CASING JOINTS: Glued XX Clamped
XX PVC 4 ABS 6 Asbestos-Cement 9 Other (specify below) Welded
7 Fiberglass Threaded

Blank casing diameter: 5 in. to 50 ft., Dia. in. to ft., Dia. in. to ft.
Casing height above land surface: 18 in., weight: 160 lbs./ft. Wall thickness or gauge No.

TYPE OF SCREEN OR PERFORATION MATERIAL:
1 Steel 3 Stainless steel 5 Fiberglass 8 RMP (SR) 10 Asbestos-cement
2 Brass 4 Galvanized steel 6 Concrete tile 9 ABS 12 None used (open hole)

SCREEN OR PERFORATION OPENINGS ARE:
1 Continuous slot XX Mill slot 5 Gauzed wrapped 8 Saw cut 11 None (open hole)
2 Louvered shutter 4 Key punched 6 Wire wrapped 9 Drilled holes
7 Torch cut 10 Other (specify)

SCREEN-PERFORATED INTERVALS: From 50 ft. to 70 ft., From ft. to ft.
GRAVEL PACK INTERVALS: From 30 ft. to 70 ft., From ft. to ft.

6 GROUT MATERIAL: 1 Neat cement 2 Cement grout XX Bentonite 4 Other

Grout Intervals: From 0 ft. to 30 ft., From ft. to ft., From ft. to ft.

What is the nearest source of possible contamination:
1 Septic tank 4 Lateral lines 7 Pit privy 10 Livestock pens 14 Abandoned water well
2 Sewer lines 5 Cess pool 8 Sewage lagoon 11 Fuel storage 15 Oil well/Gas well
3 Watertight sewer lines 6 Seepage pit 9 Feedyard 12 Fertilizer storage 16 Other (specify below)
13 Insecticide storage

Direction from well? How many feet?

FROM	TO	LITHOLOGIC LOG	FROM	TO	PLUGGING INTERVALS
0	5	SURFACE CLAY			
5	25	HARD YELLOW CLAY			
25	40	MED SAND			
40	50	HARD GRAY CLAY			
50	55	FINE SAND			
55	65	MED SAND			
65	70	SOAPSTONE			

7 CONTRACTOR'S OR LANDOWNER'S CERTIFICATION: This water well was (1) constructed, (2) reconstructed, or (3) plugged under my jurisdiction and was completed on (mo/day/year) 7-1-98 and this record is true to the best of my knowledge and belief. Kansas Water Well Contractor's License No. 444 This Water Well Record was completed on (mo/day/yr) 7-1-98 under the business name of ANDY ANDERSON DRILLING by (signature) Andy Anderson

INSTRUCTIONS: Use typewriter or ball point pen. PLEASE PRESS FIRMLY and PRINT clearly. Please fill in blanks, underline or circle the correct answers. Send top three copies to Kansas Department of Health and Environment, Bureau of Water, Topeka, Kansas 66620-0001. Telephone: 913-296-5545. Send one to WATER WELL OWNER and retain one for your records.

OFFICE USE ONLY
T
R
EW
SEC.