


1 LOCATION OF WATER WELL: County: **ELLIS** Fraction: **NE 1/4 NW 1/4 NW 1/4** Section Number: **28** Township Number: **T 13 S** Range Number: **R 18 E (W)**

Distance and direction from nearest town or city street address of well if located within city?
In the city of Hays, KS 6 523 W 35th Street, Hays KS

2 WATER WELL OWNER: **GLENN D DIEHL**
 RR#, St. Address, Box #: **523 W 35th St** Board of Agriculture, Division of Water Resources
 City, State, ZIP Code: **HAYS KS 67601** Application Number:

3 LOCATE WELL'S LOCATION WITH AN "X" IN SECTION BOX:

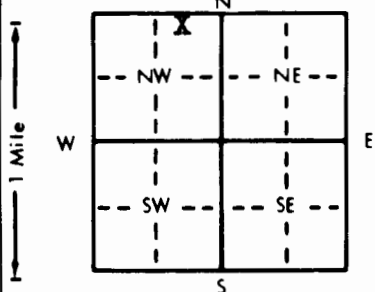

4 DEPTH OF COMPLETED WELL: **70** ft. ELEVATION:

Depth(s) Groundwater Encountered 1. **52** ft. 2. ft. 3. ft.
 WELL'S STATIC WATER LEVEL: **45** ft. below land surface measured on mo/day/yr **7-25-95**
 Pump test data: Well water was ft. after hours pumping gpm
 Est. Yield **100** gpm Well water was ft. after hours pumping gpm
 Bore Hole Diameter: **10** in. to **70** ft., and in. to ft.
 WELL WATER TO BE USED AS:
 1 Domestic 2 Irrigation 3 Feedlot 4 Industrial Lawn and garden only 5 Public water supply 6 Oil field water supply 7 Fiberglass 8 Air conditioning 9 Dewatering 10 Monitoring well 11 Injection well 12 Other (Specify below)
 Was a chemical/bacteriological sample submitted to Department? Yes No If yes, mo/day/yr sample was submitted Water Well Disinfected? Yes No

5 TYPE OF BLANK CASING USED: 1 Steel 2 Brass 3 RMP (SR) 4 ABS 5 Wrought iron 6 Asbestos-Cement 7 Fiberglass 8 Concrete tile 9 Other (specify below) CASING JOINTS: Glued Clamped Welded Threaded

Blank casing diameter: **5** in. to **50** ft., Dia in. to ft., Dia in. to ft.
 Casing height above land surface: **20** in., weight **160** lbs./ft. Wall thickness or gauge No.

TYPE OF SCREEN OR PERFORATION MATERIAL: 1 Steel 2 Brass 3 Stainless steel 4 Galvanized steel 5 Fiberglass 6 Concrete tile 7 Torched cut 8 RMP (SR) 9 ABS 10 Asbestos-cement 11 Other (specify) 12 None used (open hole)

SCREEN OR PERFORATION OPENINGS ARE: 1 Continuous slot 2 Louvered shutter 3 Mill slot 4 Key punched 5 Gauzed wrapped 6 Wire wrapped 7 Torch cut 8 Saw cut 9 Drilled holes 10 Other (specify) 11 None (open hole)

SCREEN-PERFORATED INTERVALS: From **50** ft. to **70** ft., From ft. to ft., From ft. to ft.
 GRAVEL PACK INTERVALS: From **40** ft. to **70** ft., From ft. to ft., From ft. to ft.

6 GROUT MATERIAL: 1 Neat cement 2 Cement grout 3 Bentonite 4 Other
 Grout Intervals: From **0** ft. to **30** ft., From ft. to ft., From ft. to ft.

What is the nearest source of possible contamination:
 1 Septic tank 2 Sewer lines 3 Watertight sewer lines 4 Lateral lines 5 Cess pool 6 Seepage pit 7 Pit privy 8 Sewage lagoon 9 Feedyard 10 Livestock pens 11 Fuel storage 12 Fertilizer storage 13 Insecticide storage 14 Abandoned water well 15 Oil well/Gas well 16 Other (specify below)

Direction from well? How many feet?

FROM	TO	LITHOLOGIC LOG	FROM	TO	PLUGGING INTERVALS
0	5	Surface Clay			
5	42	Hard Yellow Clay			
42	52	Med Sand			
52	60	Large Sand			
60	64	Water Rock white			
64	68	Gray Clays			
68	70	Blue Shale			

7 CONTRACTOR'S OR LANDOWNER'S CERTIFICATION: This water well was (1) constructed, (2) reconstructed, or (3) plugged under my jurisdiction and was completed on (mo/day/year) **7-25-95** and this record is true to the best of my knowledge and belief. Kansas Water Well Contractor's License No. **444** This Water Well Record was completed on (mo/day/yr) **7-25-95** under the business name of **ANDERSON DRILLING** by (signature) *Cindy Anderson*