


MW-10 241131

1 LOCATION OF WATER WELL: County: <u>Ellis</u>	Fraction <u>SE 1/4 NW 1/4 NW 1/4</u>	Section Number <u>32</u>	Township Number <u>T 13 S</u>	Range Number <u>R 18 EW</u>
---	---	-----------------------------	----------------------------------	--------------------------------

Distance and direction from nearest town or city street address of well if located within city?
675' N, 1,075' NE of Moose Rd & Alt Hwy 183

2 WATER WELL OWNER: RR#, St. Address, Box # : City, State, ZIP Code :	<u>KDHE Forbes Field, Bldg 740 Topeka KS 66620</u>	Board of Agriculture, Division of Water Resources Application Number: <u>1994.82</u>
---	--	--

3 LOCATE WELL'S LOCATION WITH AN "X" IN SECTION BOX:

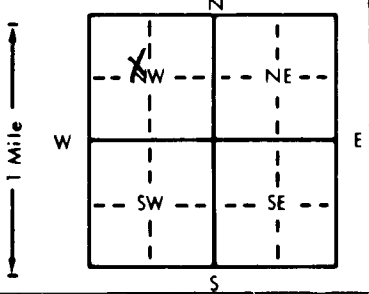

4 DEPTH OF COMPLETED WELL: <u>35</u> ft. ELEVATION: <u>1994.82</u>
Depth(s) Groundwater Encountered 1. <u>7</u> ft. 2. _____ ft. 3. _____ ft.
WELL'S STATIC WATER LEVEL <u>10.12</u> ft. below land surface measured on mo/day/yr <u>3-5-98</u>
Pump test data: Well water was _____ ft. after _____ hours pumping _____ gpm
Est. Yield _____ gpm: Well water was _____ ft. after _____ hours pumping _____ gpm
Bore Hole Diameter <u>8</u> in. to <u>35</u> ft., and _____ in. to _____ ft.
WELL WATER TO BE USED AS:
1 Domestic 3 Feedlot 6 Oil field water supply 9 Dewatering 12 Other (Specify below)
2 Irrigation 4 Industrial 7 Lawn and garden only <u>10 Monitoring well</u>
Was a chemical/bacteriological sample submitted to Department? Yes _____ No <u>X</u> ; If yes, mo/day/yr sample was submitted _____
Water Well Disinfected? Yes _____ No <u>X</u>

5 TYPE OF BLANK CASING USED:	5 Wrought iron	8 Concrete tile	CASING JOINTS: Glued _____ Clamped _____
1 Steel	3 RMP (SR)	6 Asbestos-Cement	9 Other (specify below)
<u>2 PVC</u>	4 ABS	7 Fiberglass	Welded _____
Blank casing diameter <u>2</u> in. to <u>15</u> ft., Dia _____ in. to _____ ft., Dia _____ in. to _____ ft.			<u>Threaded</u> <u>Flush</u>
Casing height above land surface <u>36.24</u> in., weight <u>70.3</u> lbs./ft. Wall thickness or gauge No. <u>Sch 40</u>			
TYPE OF SCREEN OR PERFORATION MATERIAL:			
1 Steel	3 Stainless steel	5 Fiberglass	8 RMP (SR)
2 Brass	4 Galvanized steel	6 Concrete tile	9 ABS
10 Asbestos-cement	11 Other (specify) _____	12 None used (open hole)	
SCREEN OR PERFORATION OPENINGS ARE:			
1 Continuous slot	<u>3 Mill slot</u>	5 Gauzed wrapped	8 Saw cut
2 Louvered shutter	4 Key punched	6 Wire wrapped	9 Drilled holes
7 Torch cut	10 Other (specify) _____	11 None (open hole)	
SCREEN-PERFORATED INTERVALS: From <u>15</u> ft. to <u>35</u> ft., From _____ ft. to _____ ft.			
GRAVEL PACK INTERVALS: From <u>10</u> ft. to <u>35</u> ft., From _____ ft. to _____ ft.			

6 GROUT MATERIAL:	1 Neat cement	2 Cement grout	<u>3 Bentonite</u>	4 Other _____
Grout Intervals: From <u>1</u> ft. to <u>10</u> ft., From _____ ft. to _____ ft.				
What is the nearest source of possible contamination:				
1 Septic tank	4 Lateral lines	7 Pit privy	10 Livestock pens	14 Abandoned water well
2 Sewer lines	5 Cess pool	8 Sewage lagoon	11 Fuel storage	15 Oil well/Gas well
3 Watertight sewer lines	6 Seepage pit	9 Feedyard	12 Fertilizer storage	16 Other (specify below)
13 Insecticide storage				
Direction from well?			How many feet?	

FROM	TO	LITHOLOGIC LOG	FROM	TO	PLUGGING INTERVALS
0	1.5	Clay, silty			
1.5	15	Clay, v. silty, sandy			
15	20	silt, v. sandy, clayey			
20	35	Sand med - f.c.s.			
35		Shale			

7 CONTRACTOR'S OR LANDOWNER'S CERTIFICATION: This water well was <u>(1) constructed</u> , (2) reconstructed, or (3) plugged under my jurisdiction and was completed on (mo/day/year) <u>5/4/98</u> and this record is true to the best of my knowledge and belief. Kansas Water Well Contractor's License No. <u>531</u> This Water Well Record was completed on (mo/day/yr) <u>5/5/98</u> under the business name of <u>GSI</u> by (signature) <u>Allison M. Krueger</u>

OFFICE USE ONLY
T
R
EW
SEC.