

MW-11 2411131

KS ID # 267995


1 LOCATION OF WATER WELL: County: <u>Ellis</u>	Fraction <u>SE 1/4 NW 1/4 NW 1/4</u>	Section Number <u>32</u>	Township Number <u>T 13 S</u>	Range Number <u>R 18 E/W</u>
---	---	-----------------------------	----------------------------------	---------------------------------

Distance and direction from nearest town or city street address of well if located within city?

1500 W. 27th St. (NW corner of property)

2 WATER WELL OWNER: RR#, St. Address, Box # : City, State, ZIP Code :	<u>KDHE</u> <u>Forbes Field, Bldg 740</u> <u>Topeka, KS 66629</u>	Board of Agriculture, Division of Water Resources Application Number:
---	---	--

3 LOCATE WELL'S LOCATION WITH AN "X" IN SECTION BOX:
--

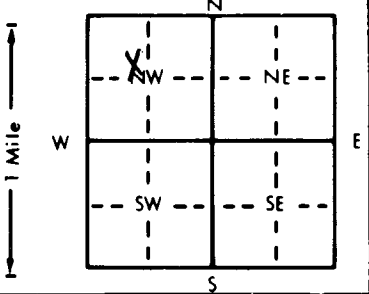

4 DEPTH OF COMPLETED WELL: <u>44</u> ft.	ELEVATION: <u>2004.96</u>
Depth(s) Groundwater Encountered: 1. <u>17</u> ft. 2. _____ ft. 3. _____ ft.	
WELL'S STATIC WATER LEVEL: <u>20.63</u> ft. below land surface measured on mo/day/yr <u>3-5-98</u>	
Pump test data: Well water was _____ ft. after _____ hours pumping _____ gpm	
Est. Yield _____ gpm: Well water was _____ ft. after _____ hours pumping _____ gpm	
Bore Hole Diameter: <u>8</u> in. to <u>44</u> ft., and _____ in. to _____ ft.	
WELL WATER TO BE USED AS:	
1 Domestic	2 Irrigation
3 Feedlot	4 Industrial
5 Public water supply	6 Oil field water supply
7 Lawn and garden only	8 Air conditioning
9 Dewatering	10 <u>Monitoring well</u>
11 Injection well	12 Other (Specify below)
Was a chemical/bacteriological sample submitted to Department? Yes _____ No <u>X</u> _____; If yes, mo/day/yr sample was submitted	
Water Well Disinfected? Yes _____ No <u>X</u> _____	

5 TYPE OF BLANK CASING USED:	5 Wrought iron	8 Concrete tile	CASING JOINTS: Glued _____ Clamped _____
1 Steel	3 RMP (SR)	6 Asbestos-Cement	9 Other (specify below)
<u>2 PVC</u>	4 ABS	7 Fiberglass	Welded _____
Blank casing diameter: <u>2</u> in. to <u>19</u> ft., Dia _____ in. to _____ ft., Dia _____ in. to _____ ft.			Threaded <u>Flush</u>
Casing height above land surface: <u>39</u> in., weight _____, Dia _____, lbs./ft. Wall thickness or gauge No. <u>Sch 40</u>			
TYPE OF SCREEN OR PERFORATION MATERIAL:	1 Steel	3 Stainless steel	5 Fiberglass
2 Brass	4 Galvanized steel	6 Concrete tile	8 RMP (SR)
SCREEN OR PERFORATION OPENINGS ARE:	1 Continuous slot	<u>3 Mill slot</u>	5 Gauzed wrapped
2 Louvered shutter	4 Key punched	6 Wire wrapped	8 Saw cut
SCREEN-PERFORATED INTERVALS:	From _____ ft. to _____ ft.	From _____ ft. to _____ ft.	From _____ ft. to _____ ft.
GRAVEL PACK INTERVALS:	From _____ ft. to _____ ft.	From _____ ft. to _____ ft.	From _____ ft. to _____ ft.
	From _____ ft. to _____ ft.	From _____ ft. to _____ ft.	From _____ ft. to _____ ft.

6 GROUT MATERIAL:	1 Neat cement	<u>2 Cement grout</u>	<u>3 Bentonite</u>	4 Other _____
Grout Intervals: From _____ ft. to _____ ft., From _____ ft. to _____ ft., From _____ ft. to _____ ft.				
What is the nearest source of possible contamination:	1 Septic tank	4 Lateral lines	7 Pit privy	10 Livestock pens
2 Sewer lines	5 Cess pool	8 Sewage lagoon	11 Fuel storage	14 Abandoned water well
3 Watertight sewer lines	6 Seepage pit	9 Feedyard	12 Fertilizer storage	15 Oil well/Gas well
			13 Insecticide storage	16 Other (specify below)
Direction from well?			How many feet?	

FROM	TO	LITHOLOGIC LOG	FROM	TO	PLUGGING INTERVALS
0	4	Clay, v. Silty			
4	12	Silt, sl. sandy			
12	20	Clay, v. Silty, sl. sandy			
20	44	Sand			
44	45	Shale			

7 CONTRACTOR'S OR LANDOWNER'S CERTIFICATION: This water well was <u>(1) constructed</u> , (2) reconstructed, or (3) plugged under my jurisdiction and was completed on (mo/day/year) <u>5/4/98</u> and this record is true to the best of my knowledge and belief. Kansas Water Well Contractor's License No. <u>531</u> This Water Well Record was completed on (mo/day/yr) <u>5/5/98</u> under the business name of <u>GSI</u> by (signature) <u>Allison M. Jansen</u>
--

OFFICE USE ONLY  
T  
R  
EW  
SEC.