


1	LOCATION OF WATER WELL: County: Ellis	Fraction NW $\frac{1}{4}$ SW $\frac{1}{4}$ NW $\frac{1}{4}$	Section Number 27	Township Number T 13 S	Range Number R 18 W
---	---	---	-----------------------------	----------------------------------	-------------------------------

Distance and direction from nearest town or city street address of well if located within city?
3408 Vine St. - Hays

2	WATER WELL OWNER: Golden Ox RR#, St. Address, Box #: 3410 Vine St. City, State, ZIP Code: Hays, KS 67601	Board of Agriculture, Division of Water Resources Application Number: _____
---	---	--

3 LOCATE WELL'S LOCATION WITH AN "X" IN SECTION BOX:

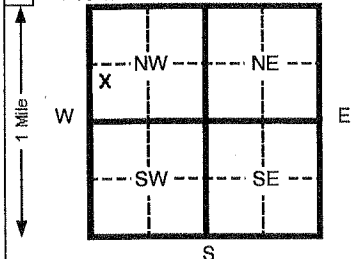

4	DEPTH OF COMPLETED WELL 30 ft. ELEVATION: 2046.07 (TOC) Depth(s) Groundwater Encountered 1 _____ ft. 2 _____ ft. 3 _____ ft. WELL'S STATIC WATER LEVEL 21.55 ft. below TOC measured on mo/day/yr 02/14/12 Pump test data: Well water was _____ ft. after _____ hours pumping _____ gpm Est. Yield _____ gpm: Well water was _____ ft. after _____ hours pumping _____ gpm Bore Hole Diameter 14 in. to 30 ft. and _____ in. to _____ ft. WELL WATER TO BE USED AS: 5 Public water supply 8 Air conditioning 11 Injection well 1 Domestic 3 Feed lot 6 Oil field water supply 9 Dewatering 12 Other (Specify below) 2 Irrigation 4 Industrial 7 Lawn and garden (domestic) 10 Monitoring well Was a chemical/bacteriological sample submitted to Department? Yes _____ No X If yes, mo/day/yr sample was submitted Water Well Disinfected? Yes _____ No X
---	--

5	TYPE OF BLANK CASING USED: 1 Steel 3 RMP (SR) 5 Wrought Iron 8 Concrete tile CASING JOINTS: Glued _____ Clamped _____ 2 PVC 4 ABS 6 Asbestos-Cement 9 Other (specify below) Welded _____ 7 Fiberglass Threaded _____ Flush Blank casing diameter 5 in. to 15 ft., Dia _____ in. to _____ ft., Dia _____ in. to _____ ft. Casing height above land surface 0 in., weight 0.703 lbs./ft. Wall thickness or gauge No. SCH. 40 TYPE OF SCREEN OR PERFORATION MATERIAL: 1 Steel 3 Stainless steel 5 Fiberglass 8 RMP (SR) 11 Other (specify) _____ 2 Brass 4 Galvanized steel 6 Concrete tile 9 ABS 12 None used (open hole) _____ SCREEN OR PERFORATION OPENINGS ARE: 1 Continuous slot 3 Mill slot 3 6 Gauzed wrapped 8 Saw cut 11 None (open hole) 2 Louvered shutter 4 Key punched 7 Wire wrapped 9 Drilled holes 10 Other (specify) _____ SCREEN-PERFORATED INTERVALS: From 15 ft. to 30 ft. From _____ ft. to _____ ft. GRAVEL PACK INTERVALS: From 13 ft. to 30 ft. From _____ ft. to _____ ft.
---	---

6	GROUT MATERIAL: 1 Neat cement 2 Cement grout 3 Bentonite 4 Other _____ Grout Intervals From 1 ft. to 13 ft. From _____ ft. to _____ ft. From _____ ft. to _____ ft. What is the nearest source of possible contamination: 1 Septic tank 4 Lateral lines 7 Pit privy 10 Livestock pens 14 Abandoned water well 2 Sewer lines 5 Cess pool 8 Sewage lagoon 11 Fuel storage 15 Oil well/ Gas well 3 Watertight sewer lines 6 Seepage pit 9 Feedyard 12 Fertilizer storage 16 Other (specify below) Direction from well? _____ How many feet? _____
---	---

FROM	TO	CODE	LITHOLOGIC LOG	FROM	TO	PLUGGING INTERVALS
0	1		Topsoil			
1	30		Clayey Silt, dark brown to gray-brown to dark gray, interbeds of gravel and sand below 23'			

GPS:
 Latitude: **38.89547**
 Longitude: **99.31756**

7	CONTRACTOR'S OR LANDOWNER'S CERTIFICATION: This water well was (1) constructed , (2) reconstructed, or (3) plugged under my jurisdiction and was completed on (mo/day/yr) 03/30/12 and this record is true to the best of my knowledge and belief. Kansas Water Well Contractor's License No. 531 This Water Well Record was completed on (mo/day/yr) 04/05/12 under the business name of Geotechnical Services Inc. by (signature) <i>[Signature]</i>
---	---

OFFICE USE ONLY

T

R

SEC

INSTRUCTIONS: Please fill in blanks and circle the correct answers. Send three copies to Kansas Department of Health and Environment, Bureau of Water, 1000 S W Jackson St., Ste. 420, Topeka, Kansas 66612-1367. Telephone: 913-296-5545. Send one to WATER WELL OWNER and retain one for your records.