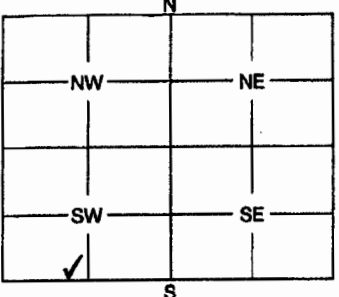


1	LOCATION OF WATER WELL: County: Ellis	Fraction SE ¼ SW ¼ SW ¼	Section Number 28	Township Number 13	Range Number 18
---	-------------------------------------------------	-----------------------------------	-----------------------------	------------------------------	---------------------------

Distance and direction from nearest town or city street address of well if located within city?
501 West 27th Street; Hays KS

2	WATER WELL OWNER: Coastal Mart #2502 2 North Nevada RR #, St. Address, Box #: Colorado Springs, CO 80903 City, State, ZIP Code	Board of Agriculture, Division of Water Resources Application Number: AS-3
---	---	--------------------------------------------------------------------------------------

3	MARK WELL'S LOCATION WITH AN "X" IN SECTION BOX: 	4	DEPTH OF WELL 56.55 ft. WELL'S STATIC WATER LEVEL 41.35 ft. WELL WAS USED AS: <table border="0"> <tr> <td>1 Domestic</td> <td>5 Public Water Supply</td> <td>9 Dewatering</td> </tr> <tr> <td>2 Irrigation</td> <td>6 Oil Field Water Supply</td> <td>10 Monitoring Well</td> </tr> <tr> <td>3 Feedlot</td> <td>7 Domestic (Lawn & Garden)</td> <td><input checked="" type="checkbox"/> 11 Injection Well</td> </tr> <tr> <td>4 Industrial</td> <td>8 Air Conditioning</td> <td>12 Other</td> </tr> </table> <p>Was a chemical / bacteriological sample submitted to Department? Yes No <input checked="" type="checkbox"/> If yes, mo/day/yr sample was submitted</p> <p>Water Well Disinfected: Yes No <input checked="" type="checkbox"/></p>	1 Domestic	5 Public Water Supply	9 Dewatering	2 Irrigation	6 Oil Field Water Supply	10 Monitoring Well	3 Feedlot	7 Domestic (Lawn & Garden)	<input checked="" type="checkbox"/> 11 Injection Well	4 Industrial	8 Air Conditioning	12 Other
1 Domestic	5 Public Water Supply	9 Dewatering													
2 Irrigation	6 Oil Field Water Supply	10 Monitoring Well													
3 Feedlot	7 Domestic (Lawn & Garden)	<input checked="" type="checkbox"/> 11 Injection Well													
4 Industrial	8 Air Conditioning	12 Other													

5	TYPE OF BLANK CASING USED: <table border="0"> <tr> <td>1 Steel</td> <td>3 RMP (SR)</td> <td>5 Wrought</td> <td>7 Fiberglass</td> <td>9 Other (Specify below)</td> </tr> <tr> <td><input checked="" type="checkbox"/> 2 PVC</td> <td>4 ABS</td> <td>6 Asbestos-Cement</td> <td>8 Concrete Tile</td> <td></td> </tr> </table> <p>Blank casing diameter 2" in. Was casing pulled? Yes <input checked="" type="checkbox"/> No If yes, how much 3' Casing height above or <u>below</u> land surface 36 in.</p>	1 Steel	3 RMP (SR)	5 Wrought	7 Fiberglass	9 Other (Specify below)	<input checked="" type="checkbox"/> 2 PVC	4 ABS	6 Asbestos-Cement	8 Concrete Tile	
1 Steel	3 RMP (SR)	5 Wrought	7 Fiberglass	9 Other (Specify below)							
<input checked="" type="checkbox"/> 2 PVC	4 ABS	6 Asbestos-Cement	8 Concrete Tile								

6	GROUT PLUG MATERIAL: 1 Neat cement 2 Cement grout <input checked="" type="checkbox"/> Bentonite 4 Other Grout Plug Intervals: From 3 ft. to 40 ft., From ft. to ft., From to ft. What is the nearest source of possible contamination: <table border="0"> <tr> <td>1 Septic tank</td> <td>6 Seepage pit</td> <td>11 Fuel storage</td> <td>16 Other (specify below)</td> </tr> <tr> <td>2 Sewer lines</td> <td>7 Pit privy</td> <td>12 Fertilizer storage</td> <td></td> </tr> <tr> <td>3 Watertight sewer lines</td> <td>8 Sewage lagoon</td> <td>13 Insecticide storage</td> <td></td> </tr> <tr> <td>4 Lateral lines</td> <td>9 Feedyard</td> <td>14 Abandoned water well</td> <td></td> </tr> <tr> <td>5 Cess pool</td> <td>10 Livestock pens</td> <td>15 Oil well/Gas well</td> <td></td> </tr> </table> <p>Direction from well? How many feet?</p>	1 Septic tank	6 Seepage pit	11 Fuel storage	16 Other (specify below)	2 Sewer lines	7 Pit privy	12 Fertilizer storage		3 Watertight sewer lines	8 Sewage lagoon	13 Insecticide storage		4 Lateral lines	9 Feedyard	14 Abandoned water well		5 Cess pool	10 Livestock pens	15 Oil well/Gas well	
1 Septic tank	6 Seepage pit	11 Fuel storage	16 Other (specify below)																		
2 Sewer lines	7 Pit privy	12 Fertilizer storage																			
3 Watertight sewer lines	8 Sewage lagoon	13 Insecticide storage																			
4 Lateral lines	9 Feedyard	14 Abandoned water well																			
5 Cess pool	10 Livestock pens	15 Oil well/Gas well																			

FROM	TO	PLUGGING MATERIALS
0	3	native soil
3	40	bentonite
40	56.55	sand

7	CONTRACTOR'S OR LANDOWNER'S CERTIFICATION: This water well was plugged under my jurisdiction and was completed on (mo/day/year) 9/19/11 and this record is true to the best of my knowledge and belief. Kansas Water Well Contractor's License No. 735 This Water Well Record was completed on (mo/day/year) 9/29/2011 by (signature) <i>[Signature]</i> under the business name of MILCO Environmental Services, Inc.
---	---

INSTRUCTIONS: Use typewriter or ball point pen. Please press firmly and print clearly. Please fill in blanks, underline or circle the correct answers. Send top three copies to Kansas Department of Health and Environment, Bureau of Water, Geology Section, 1000 SW Jackson St., Ste. 420, Topeka, Kansas 66612-1367. Telephone: 785/296-5522. Send one to Water Well Owner and retain one for your records.