


1	LOCATION OF WATER WELL:	Fraction	Section Number	Township Number	Range Number
County:	Ellis	SE ¼ SW ¼ SW ¼	28	13	18

Distance and direction from nearest town or city street address of well if located within city?  
501 West 27th Street; Hays KS

2	WATER WELL OWNER:	Coastal Mart #2502	Board of Agriculture, Division of Water Resources
	RR #, St. Address, Box #:	2 North Nevada	Application Number: AS-5
	City, State, ZIP Code :	Colorado Springs, CO 80903	

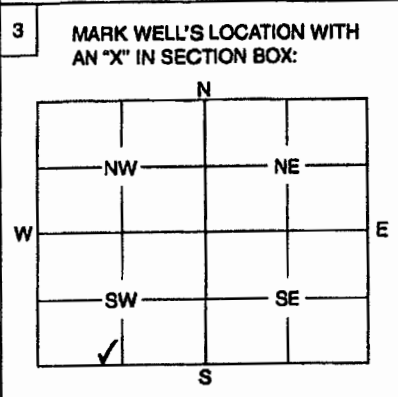

4	DEPTH OF WELL	49.70	ft.
	WELL'S STATIC WATER LEVEL	41.70	ft.
WELL WAS USED AS:			
1	Domestic	5	Public Water Supply
2	Irrigation	6	Oil Field Water Supply
3	Feedlot	7	Domestic (Lawn & Garden)
4	Industrial	8	Air Conditioning
		9	Dewatering
		10	Monitoring Well
		<input checked="" type="checkbox"/>	Injection Well
		12	Other

Was a chemical / bacteriological sample submitted to Department? Yes ..... No  .....  
If yes, mo/day/yr sample was submitted .....

Water Well Disinfected: Yes ..... No  .....

5 TYPE OF BLANK CASING USED:

1 Steel	3 RMP (SR)	5 Wrought	7 Fiberglass	9 Other (Specify below)
<input checked="" type="checkbox"/> 2 PVC	4 ABS	6 Asbestos-Cement	8 Concrete Tile	

Blank casing diameter ..... 2" in. Was casing pulled? Yes  No ..... If yes, how much 3' .....  
Casing height above or below land surface ..... 36" in.

6 GROUT PLUG MATERIAL: 1 Neat cement 2 Cement grout  Bentonite 4 Other .....

Grout Plug Intervals: From 3 ft. to 41 ft., From ..... ft. to ..... ft., From ..... to ..... ft.

What is the nearest source of possible contamination:

1 Septic tank	6 Seepage pit	11 Fuel storage	16 Other (specify below)
2 Sewer lines	7 Pit privy	12 Fertilizer storage	
3 Watertight sewer lines	8 Sewage lagoon	13 Insecticide storage	
4 Lateral lines	9 Feedyard	14 Abandoned water well	
5 Cess pool	10 Livestock pens	15 Oil well/Gas well	

Direction from well? ..... How many feet? .....

FROM	TO	PLUGGING MATERIALS
0	3	native soil
3	41	bentonite
41	49.70	sand

7 CONTRACTOR'S OR LANDOWNER'S CERTIFICATION: This water well was plugged under my jurisdiction and was completed on (mo/day/year) 9/19/11 and this record is true to the best of my knowledge and belief. Kansas Water Well Contractor's License No. 735 This Water Well Record was completed on (mo/day/year) 9/29/2011 under the business name of MILCO Environmental Services, Inc. by (signature) *[Signature]*

INSTRUCTIONS: Use typewriter or ball point pen. Please press firmly and print clearly. Please fill in blanks, underline or circle the correct answers. Send top three copies to Kansas Department of Health and Environment, Bureau of Water, Geology Section, 1000 SW Jackson St., Ste. 420, Topeka, Kansas 66612-1367. Telephone: 785/298-5522. Send one to Water Well Owner and retain one for your records.