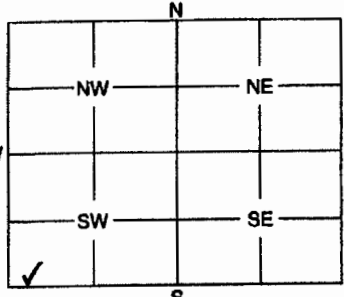


1	LOCATION OF WATER WELL:	Fraction	Section Number	Township Number	Range Number
County:	Ellis	SW ¼ SW ¼ SW ¼	28	13	18

Distance and direction from nearest town or city street address of well if located within city?  
501 West 27th Street; Hays KS

2	WATER WELL OWNER:	Coastal Mart #2502	Board of Agriculture, Division of Water Resources
	RR #, St. Address, Box #:	2 North Nevada	Application Number: OBS-1
	City, State, ZIP Code :	Colorado Springs, CO 80903	

3	MARK WELL'S LOCATION WITH AN "X" IN SECTION BOX:	4	DEPTH OF WELL 48.20 ft.
			WELL'S STATIC WATER LEVEL 41.70 ft.
			WELL WAS USED AS:
			1 Domestic                      5 Public Water Supply                      9 Dewatering 2 Irrigation                      6 Oil Field Water Supply <input checked="" type="checkbox"/> Monitoring Well 3 Feedlot                      7 Domestic (Lawn & Garden)                      11 Injection Well 4 Industrial                      8 Air Conditioning                      12 Other .....
			Was a chemical / bacteriological sample submitted to Department? Yes ..... No <input checked="" type="checkbox"/>
			If yes, mo/day/yr sample was submitted .....
			Water Well Disinfected: Yes ..... No <input checked="" type="checkbox"/>

5	TYPE OF BLANK CASING USED:
	1 Steel      3 RMP (SR)      5 Wrought      7 Fiberglass      9 Other (Specify below) <input checked="" type="checkbox"/> 2 PVC      4 ABS      6 Asbestos-Cement      8 Concrete Tile
	Blank casing diameter 4" in. Was casing pulled? Yes <input checked="" type="checkbox"/> No ..... If yes, how much 3' .....
	Casing height above or below land surface 36 in. ....

6	GROUT PLUG MATERIAL:	1 Neat cement	2 Cement grout	<input checked="" type="checkbox"/> Bentonite	4 Other .....
	GROUT PLUG INTERVALS:	From 3 ft.	to 41 ft.	From ..... ft.	to ..... ft.
	What is the nearest source of possible contamination:				
	1 Septic tank                      6 Seepage pit                      11 Fuel storage                      16 Other (specify below) 2 Sewer lines                      7 Pit privy                      12 Fertilizer storage 3 Waterlight sewer lines                      8 Sewage lagoon                      13 Insecticide storage 4 Lateral lines                      9 Feedyard                      14 Abandoned water well 5 Cess pool                      10 Livestock pens                      15 Oil well/Gas well				
	Direction from well? .....	How many feet? .....			

FROM	TO	PLUGGING MATERIALS
0	3	native soil
3	41	bentonite
41	48.20	sand

7	CONTRACTOR'S OR LANDOWNER'S CERTIFICATION: This water well was plugged under my jurisdiction and was completed on (mo/day/year) 9/19/11 and this record is true to the best of my knowledge and belief. Kansas Water Well Contractor's License No. 735 This Water Well Record was completed on (mo/day/year) 9/29/2011 under the business name of MILCO Environmental Services, Inc. by (signature) <i>[Signature]</i>
---	--

INSTRUCTIONS: Use typewriter or ball point pen. Please press firmly and print clearly. Please fill in blanks, underline or circle the correct answers. Send top three copies to Kansas Department of Health and Environment, Bureau of Water, Geology Section, 1000 SW Jackson St., Ste. 420, Topeka, Kansas 66612-1367. Telephone: 785/296-5522. Send one to Water Well Owner and retain one for your records.