

(Well #3)

WATER WELL PLUGGING RECORD Form WWC-5P KSA 82a-1212 ID NO. [ ]

1 LOCATION OF WATER WELL: Fraction  $\frac{1}{4}$  C  $\frac{1}{4}$  NW  $\frac{1}{4}$  NW  $\frac{1}{4}$  Section Number 27 Township Number T 13 S Range Number 18  E  W


Street/Rural Address of Well Location; if unknown, distance & direction from nearest town or intersection: If at owner's address, check here  22ND & VINE WAYS, KS 67601

Global Positioning Systems (GPS) information: Latitude: 38.878569 (in decimal degrees) Longitude: -99.317615 (in decimal degrees) Elevation: 2026 FT. Datum:  WGS84,  NAD83,  NAD27 Collection Method:

2 WATER WELL OWNER: KDOT RR#, St. Address, Box #: 700 SW HARRISON City, State ZIP Code: TOPEKA, KS 66603

GPS unit (Make/Model):  Digital Map/Photo,  Topographic Map,  Land Survey Est. Accuracy:  <3 m,  3-5 m,  5-15 m,  >15 m

3 MARK WELL'S LOCATION WITH AN "X" IN SECTION BOX:

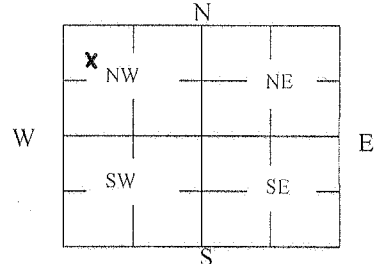

4 DEPTH OF WELL 78 ft. WELL'S STATIC WATER LEVEL 53 ft. WELL WAS USED AS:

- Domestic  Irrigation  Feedlot  Industrial  Public Water Supply  Oil Field Water Supply  Domestic (Lawn & Garden)  Air Conditioning  Dewatering  Monitoring  Injection Well  Other OBSERVATIONAL

Was a chemical/bacteriological sample submitted to Department? Yes  No

5 TYPE OF BLANK CASING USED:

- Steel  RMP (SR)  Wrought  Fiberglass  Other (Specify below)  PVC  ABS  Asbestos-Cement  Concrete Tile

Blank casing diameter 5 1/2 in. Was casing pulled? Yes  No  If yes, how much Casing height above or below land surface 12 in.

6 GROUT PLUG MATERIAL:  Neat cement  Cement grout  Bentonite  Other

Grout Plug Intervals: From 1 ft. to 54 ft., From ft. to ft., From ft. to ft.

- What is the nearest source of possible contamination:
- Septic tank  Sewer lines  Watertight sewer lines  Lateral lines  Cess pool  Seepage pit  Pit privy  Sewage lagoon  Feedyard  Livestock pens  Fuel storage  Fertilizer storage  Insecticide storage  Abandoned water well  Oil well/Gas well  Other (specify below)
- Direction from well? UNKNOWN How many feet? UNKNOWN

FROM	TO	PLUGGING MATERIALS	FROM	TO	PLUGGING MATERIALS
0	1	TOP SOIL			
1	54	BENTONITE			
54	78	SAND			

7 CONTRACTOR'S OR LANDOWNER'S CERTIFICATION: This water well was plugged under my jurisdiction and was completed on (mo/day/year) 10/24/13 and this record is true to the best of my knowledge and belief. Kansas Water Well Contractor's License No. OWNER. This Water Well Record was completed on (mo/day/year) 10/28/13 under the business name of KANSAS DEPT. OF TRANSPORTATION by (signature) [Signature]

INSTRUCTIONS: Use typewriter or ballpoint pen. Please press firmly and print clearly. Please fill in blanks, underline or circle the correct answers. Send top three copies to Kansas Department of Health and Environment, Bureau of Water, Geology Section, 1000 SW Jackson St., Ste. 420, Topeka, Kansas 66612-1367. Telephone: 785/296-5524. Send one to Water Well Owner and retain one for your records. Visit us at http://www.kdheks.gov/waterwell/index.html.