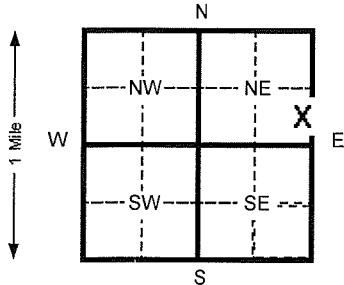


1 LOCATION OF WATER WELL: County: **Ellis** Fraction: **NE 1/4 SE 1/4 NE 1/4** Section Number: **28** Township Number: **T 13 S** Range Number: **R 18 E/W**

Distance and direction from nearest town or city street address of well if located within city?  
**3501 N Vine St, Hays, KS, Lat: N 38° 53.685', Long: 99° 19.115'**

2 WATER WELL OWNER: **Chevron**  
 RR#, St. Address, Box #: **2700 NE Seward Ave** Board of Agriculture, Division of Water Resources  
 City, State, ZIP Code: **Topeka, KS 66605** Application Number:

3 LOCATE WELL'S LOCATION WITH AN "X" IN SECTION BOX: 

4 DEPTH OF COMPLETED WELL: **35** ft. ELEVATION: **Unknown**

Depth(s) Groundwater Encountered 1 **22** ft. 2 \_\_\_\_\_ ft. 3 \_\_\_\_\_ ft.

WELL'S STATIC WATER LEVEL: **Unk.** ft. below land surface measured on mo/day/yr \_\_\_\_\_

Pump test data: Well water was **N/A** ft. after \_\_\_\_\_ hours pumping \_\_\_\_\_ gpm  
 Est. Yield **N/A** gpm: Well water was **N/A** ft. after \_\_\_\_\_ hours pumping \_\_\_\_\_ gpm

Bore Hole Diameter **10.25** in. to **35** ft. and \_\_\_\_\_ in. to \_\_\_\_\_ ft.

WELL WATER TO BE USED AS: 5 Public water supply 8 Air conditioning 11 Injection well  
 1 Domestic 3 Feed lot 6 Oil field water supply 9 Dewatering (12) Other (Specify below)  
**Remediation**

2 Irrigation 4 Industrial 7 Lawn and garden (domestic) 10 Monitoring well

Was a chemical/bacteriological sample submitted to Department? Yes \_\_\_\_\_ No **X** If yes, mo/day/yr sample was submitted \_\_\_\_\_

Water Well Disinfected? Yes \_\_\_\_\_ No **X**

5 TYPE OF BLANK CASING USED: 5 Wrought Iron 8 Concrete tile CASING JOINTS: Glued \_\_\_\_\_ Clamped \_\_\_\_\_  
 1 Steel 3 RMP (SR) 6 Asbestos-Cement 9 Other (specify below) Welded \_\_\_\_\_  
 (2) PVC 4 ABS 7 Fiberglass (Threaded)

Blank casing diameter **2\*** in. to **15** ft., Dia **1\*\*** in. to **25** ft., Dia **1** in. to **31&33-35** ft.

Casing height above land surface **0** in., weight **0.682\*/ 0.315\*\*** lbs./ft. Wall thickness or gauge No. **0.1875\*/ 0.1575\*\*** in.

TYPE OF SCREEN OR PERFORATION MATERIAL: (7) PVC 10 Asbestos-cement  
 1 Steel 3 Stainless steel 5 Fiberglass 8 RMP (SR) 11 Other (specify) \_\_\_\_\_  
 2 Brass 4 Galvanized steel 6 Concrete tile 9 ABS 12 None used (open hole)

SCREEN OR PERFORATION OPENINGS ARE: 5 Gauzed wrapped 8 Saw cut 11 None (open hole)  
 1 Continuous slot (3) Mill slot 6 Wire wrapped 9 Drilled holes  
 2 Louvered shutter 4 Key punched 7 Torch cut 10 Other (specify) \_\_\_\_\_

SCREEN-PERFORATED INTERVALS: From **15** ft. to **21 (2")** ft. From **25** ft. to **27 (1")** ft.  
 From **31** ft. to **33 (1")** ft. From \_\_\_\_\_ ft. to \_\_\_\_\_ ft.

GRAVEL PACK INTERVALS: From **0.75** ft. to **3** ft. From **14** ft. to **21** ft.  
 From **24** ft. to **27** ft. From **30** ft. to **33** ft.

6 GROUT MATERIAL: 1 Neat cement 2 Cement grout (3) Bentonite (4) Other **cement + bentonite grout<sup>1</sup>**

Grout Intervals From **3** ft. to **12'** ft. From **12 & 21** ft. to **14 & 24** ft. From **27 & 33** ft. to **30 & 35** ft.

What is the nearest source of possible contamination:  
 1 Septic tank 4 Lateral lines 7 Pit privy (10) Livestock pens 14 Abandoned water well  
 2 Sewer lines 5 Cess pool 8 Sewage lagoon (11) Fuel storage 15 Oil well/ Gas well  
 3 Watertight sewer lines 6 Seepage pit 9 Feedyard 12 Fertilizer storage 16 Other (specify below) \_\_\_\_\_  
 13 Insecticide storage

Direction from well? **within plume** How many feet? \_\_\_\_\_

FROM	TO	CODE	LITHOLOGIC LOG	FROM	TO	PLUGGING INTERVALS
0	0.5 ft.	--	concrete			
0.5	11	03	silty clay	0.75	3 ft.	<b>NOTE: ANNULUS SEALING &amp; SAND PACK</b>
11	17	02	brown, soft, clayey silt	3	12	Portland cement + bentonite grout
17	18	04	dark brown, moist, sandy clay	12	14	hydrated medium bentonite chips
18	21	02	brown, soft, clayey silt	14	21	sand
21	22	03	brown, firm, silty clay	21	24	coated bentonite chips
22	28	02	brown, clayey silt	24	27	sand
28	30	05	silty, gravelly sand	27	30	coated bentonite chips
30	30.5	04	brown, soft, sandy clay	30	33	sand
30.5	31.5	03	brown, soft, wet, silty clay	33	35	coated bentonite chips
31.5	32	04	brown, sandy, gravelly clay			
32	33.5	04	brown, wet, fine sandy clay			
33.5	35	05	brown, clayey sand			
			*for 2" casing, **for 1" casing			<sup>1</sup> for cement+bentonite grout interval

7 CONTRACTOR'S OR LANDOWNER'S CERTIFICATION: This water well was (1) constructed (2) reconstructed, or (3) plugged under my jurisdiction and was completed on (mo/day/yr) **11/9/06** and this record is true to the best of my knowledge and belief. Kansas Water Well Contractor's License No. **616** This Water Well Record was completed on (mo/day/yr) **5/22/07** under the business name of **Thiele Geotech, Inc.** by (signature)

INSTRUCTIONS: Please fill in blanks and circle the correct answers. Send three copies to Kansas Department of Health and Environment, Bureau of Water, 1000 S W Jackson St., Ste. 420, Topeka, Kansas 66612-1367. Telephone: 913-296-5545. Send one to WATER WELL OWNER and retain one for your records.

OFFICE USE ONLY

T R

SEC



**MONITORING WELL/BORING LOG**

BORING/WELL No: **SB-18/VSW-4**

Pg. 1 of 2

Former Texaco Bulk Terminal and Retail Facility # 211441 3503 North Vine Street Hays, Kansas	DRILLER: Thiele Geotech	HOLE DIAMETER: 10 1/4"
	POTHOLE METHOD: Water Knife/Vacuum Truck	SVE WELL CASING: 2" SCH 40 PVC
SAIC PROJECT #: 06-6818-00-8670-100	DRILLING METHOD: CME 55 - Hollow Stem Auger	AS WELL CASING: 1" SCH 80 PVC
	SAMPLE METHOD: 2" by 2" split spoon	SVE WELL SCREEN: 2" SCH 40 PVC
LOGGED BY: Brad Wolfinger	DRILL BIT DIAMETER: 6 1/4" I.D.	AS WELL SCREEN: 1" SCH 80 PVC Slot Size: 0.020"
	DATE POTHOLED: 11/6/06	SEAL TYPE: Granular bentonite & chips, Portland cement
	DATE DRILLED: 11/9/06	FILTER PACK: No. 10-20 Silica Sand
	WELL CONSTRUCTION 11/9/06	WELL COVER: 12" steel vault
	WELL DEVELOPMENT: N/A	CASING ELEVATION:
	GROUND ELEVATION:	

Depth (ft.)	Blow Counts	% Recovery	LITHOLOGY / DESCRIPTION	Field Screen PID (ppm)	UVIF Screening	Head Space PID (ppm)	Head Space FID (ppm)	Soil Type	USCS	Water Level	Depth (ft.)	Well Construction/Remarks	
1	Potholed to 8'	Potholed to 8'	0'-6.5" Concrete	NR	NR	1.0	2.1	CL	[Hatched]	[Water Level Arrow]	1	Sand to 0.75'	
2			6.5'-4'			1.1	2.2				Top of grout @ 3'		
3			SILTY CLAY (CL), brown, medium-high plasticity, soft, moist, <5% fine sand, no visible HC staining or odor.			1.0	1.8				Portland Cement & Bentonite Powder Grout		
4			4'-6'			1.0	1.8						
5			SILTY CLAY (CL), brown, moist, low plasticity, soft, 5-10% fine sand, more silt than above, no HC odors.			1.0	3.0						
6			6'-8'			1.0	3.0						
7			SILTY CLAY (CL), brown, moist, wet @ 6', high plasticity, very soft, 10-20% fine sand, no HC odors.			0.2	NR				12.5	0.7	
8			8'-11'			100.00%	SILTY CLAY (CL), brown, moist, high plasticity, firm, <=5% fine sand, dirty looking, but no HC odors. Sporadic CaCO <sub>3</sub> inclusions, getting softer and less plastic at 11'. Transitioning to clayey silt.				0.2	NR	19.5
9	3,4,7,9	100.00%	11'-17'	0.4	NR	20.6	11.9	ML	[Hatched]	[Water Level Arrow]	11	Hydrated Medium Bentonite Chips	
10			CLAYEY SILT (ML), brown, low plasticity, soft, moist, no HC impacts, sporadic CaCO <sub>3</sub> inclusions.			3.1	NR				53.1	44.9	Sand @ 14'
11	3,4,8,9	100.00%	17'-18'	0.6	NR	46.2	38.9	SM	[Dotted]	[Water Level Arrow]	13	SVE Screened 15'-21'	
12			SILTY, SANDY CLAY (SM), dark brown, high plasticity, very soft, moist, no HC impacts, ~20-30% fine sand, ~20-30% silt, ~40-60% clay.			1.0	NR				23.7	16.6	
13	3,4,7,8	100.00%	18'-21'	26.0	NR	186.0	114.0	ML	[Dotted]	[Water Level Arrow]	14		
14			CLAYEY SILT (ML), brown, medium plasticity, soft, moist HC mottling, but no odor.										
15	3,4,5,5	100.00%	*19-20, same as 11'-17', but more plastic, more clayey.					CL	[Hatched]	[Water Level Arrow]	15	Sample SB18-S-(20'-22')	
16			18'-21'										
17	2,3,3,3	100.00%											
18	0,0,2,2	100.00%											
19	0,2,2,4	100.00%											
20													
21													
22													

Notes:



MONITORING WELL/BORING LOG

BORING/WELL No: SB-18/VSW-4

Pg. 2 of 2

Former Texaco Bulk Terminal and Retail Facility # 211441  
3503 North Vine Street  
Hays, Kansas

DRILLER: Thiele Geotech  
POTHOLE METHOD: Water Knife/Vacuum Truck  
DRILLING METHOD: CME 55 - Hollow Stem Auger  
SAMPLE METHOD: 2" by 2" split spoon  
DRILL BIT DIAMETER: 6 1/4" I.D.  
DATE POTHOLED: 11/6/06  
DATE DRILLED: 11/9/06

HOLE DIAMETER: 10 1/4"  
SVE WELL CASING: 2" SCH 40 PVC  
AS WELL CASING: 1" SCH 80 PVC  
SVE WELL SCREEN: 2" SCH 40 PVC  
AS WELL SCREEN: 1" SCH 80 PVC  
Slot Size: 0.020"  
SEAL TYPE: Granular bentonite & chips, Portland cement  
FILTER PACK: No. 10-20 Silica Sand  
WELL COVER: 12" steel vault

SAIC PROJECT #:  
06-6818-00-8670-100

WELL CONSTRUCTION 11/9/06  
WELL DEVELOPMENT: N/A

LOGGED BY: Brad Wolfinger

GROUND ELEVATION:

CASING ELEVATION:

Depth (ft.)	Blow Counts	% Recovery	LITHOLOGY / DESCRIPTION	Field Screen PID (ppm)	UV/F Screening	Head Space PID (ppm)	Head Space FID (ppm)	Soil Type	USCS	Water Level	Depth (ft.)	Well Construction/Remarks
22			21'-22'								22	
23	4,7,9,11	100.00%	SILTY CLAY (CL), brown, moist, firm, medium plasticity, no HC impacts or odor.	28.2	NR	3084.0	4153.0				23	Coated bentonite chips
24			22'-28'								24	
25	3,3,5,5	100.00%	CLAYEY SILT (ML), brown, moist-wet, medium plasticity, firm, sporadic CaCO <sub>3</sub> inclusions, HC odor starting at 23'.	1097.0	CaCO <sub>3</sub> Inc. Glow	4138.0	5000 FO	ML			25	Sand @ 24' Sample SB18-S-(24'-26')
26											26	
27	2,3,5,4	100.00%	*silty, dirty sand @24', ~2" thick. *silty, dirty sand @24.5', ~3" thick. HC staining and odor widespread 24'-26'. *sand seam at 27', ~5" thick, limestone fragments at bottom of seam, coarse grained sand.	823.0	CaCO <sub>3</sub> Inc. Glow	3598.0	5000 FO				27	AS Screened 25'-27' Sample SB16-S-(26'-28')
28											28	Coated bentonite chips
29	0,2,5,7	58.33%	*sandy, clayey, silty fine grained sand seam 27.5'-28'.	2.3	NR	13.5	1052.0	SP			29	Sample SB18-S-(28'-30')
30			28'-30'								30	
31	1,2,1,2	100.00%	SILTY GRAVELLY SAND (SP), gray, minor HC odor, poorly sorted, graded down to larger grained sand/gravel from 27.5'-28' interval. No HC staining, impacts and odors decreasing at 28', basically gone at 30'.	1.3	NR	151.0	89.8	CL			31	Sand @ 30' Sample SB18-S-(30'-32')
32											32	AS Screened 31'-33'
33	0,3,9,9	100.00%	30'-30.5' SANDY CLAY (SC), brown, soft, fine to medium grained, wet, no HC impacts.	1.3	NR	51.1	23.7	SC			33	
34											34	Coated bentonite chips
35			30.5'-31.5' SILTY CLAY (CL), brown, soft, medium-high plasticity, wet, no HC impacts.								35	
36											36	
37			31.5'-32' SANDY GRAVELLY CLAY (SC), brown, poorly sorted, wet, no HC impacts.								37	
38											38	
39			32'-33.5' SANDY CLAY (SC), brown, wet, fine grained sand, no HC impacts.								39	
40											40	
41			33.5'-34' CLAYEY SAND (SC), brown, wet, fine to coarse grained, no HC impacts.								41	
42											42	
43											43	

Notes: