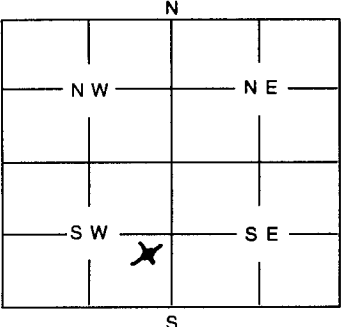


1	LOCATION OF WATER WELL: County: <u>ELLIS</u>	Fraction <u>NE 1/4 SE 1/4 SW 1/4</u>	Section Number <u>33</u>	Township Number <u>13</u>	Range Number <u>18 N</u>
---	---	---	-----------------------------	------------------------------	-----------------------------

Distance and direction from nearest town or city street address of well if located within city?

1302 MAIN ST. HAYS KS

2	WATER WELL OWNER: <u>Dan &amp; Carol Scheck</u> RR #, St. Address, Box #: <u>1302 main</u> City, State, ZIP Code: <u>HAYS KANSAS 67601</u>	Board of Agriculture, Division of Water Resources Application Number:
---	--	--

3	MARK WELL'S LOCATION WITH AN "X" IN SECTION BOX: 	4	DEPTH OF WELL ..... <u>27.5</u> ft WELL'S STATIC WATER LEVEL <u>24.52</u> ft. <u>b to c</u> WELL WAS USED AS: 1 Domestic 2 Irrigation 3 Feedlot 4 Industrial 5 Public Water Supply 6 Oil Field Water Supply 7 Domestic (Lawn & Garden) 8 Air Conditioning 9 Dewatering 10 <u>Monitoring Well</u> 11 Injection Well 12 Other ..... Was a chemical / bacteriological sample submitted to Department? Yes <input checked="" type="checkbox"/> No ..... If yes, mo/day/yr sample was submitted <u>6-25-15</u> for VOCs Water Well Disinfected: Yes ..... No <input checked="" type="checkbox"/> <u>Gasoline contamination present.</u>
---	---	---	--

5	TYPE OF BLANK CASING USED: 1 Steel 2 <u>PVC</u> 3 RMP (SR) 4 ABS 5 Wrought 6 Asbestos-Cement 7 Fiberglass 8 Concrete Tile 9 Other (Specify below) ..... Blank casing diameter <u>2</u> in. Was casing pulled? Yes ..... No <input checked="" type="checkbox"/> If yes, how much ..... Casing height above or below land surface <u>6</u> in.
---	---

6	GROUT PLUG MATERIAL: 1 Neat cement 2 Cement grout 3 <u>Bentonite</u> 4 Other <u>Gravel to top of water</u> Grout Plug Intervals: From <u>27.5</u> ft. to <u>25</u> ft., From <u>25</u> ft. to <u>2.5</u> ft., From <u>2.5</u> to <u>0</u> ft. What is the nearest source of possible contamination: 1 Septic tank 2 Sewer lines 3 Watertight sewer lines 4 Lateral lines 5 Cess Pool 6 Seepage pit 7 Pit privy 8 Sewage lagoon 9 Feedyard 10 Livestock pens 11 <u>Fuel storage</u> 12 Fertilizer storage 13 Insecticide storage 14 Abandoned water well 15 Oil well/Gas well 16 Other (specify below) ..... Direction from well? <u>NW</u> How many feet? <u>~150'</u>
---	--

FROM	TO	PLUGGING MATERIALS
<u>27.5'</u>	<u>25'</u>	<u>1/4-1/2" gravel</u>
<u>25'</u>	<u>2.5'</u>	<u>Bentonite chips (later hydrated)</u>
<u>2.5'</u>	<u>0</u>	<u>Soil + concrete walk</u>

*MW-3 plugged and abandoned in anticipation (July 2015) of street + walk renovation on 13th St.*

7	CONTRACTOR'S OR LANDOWNER'S CERTIFICATION: This water well was plugged under my jurisdiction and was completed on (mo/day/year) <u>6-24-15</u> and this record is true to the best of my knowledge and belief. Kansas Water Well Contractor's License No. <u>KDHE</u> This Water Well Record was completed on (mo/day/year) <u>6-25-15</u> under the business name of <u>KDHE - NWDO</u> by (signature) <u>[Signature]</u>
---	---

INSTRUCTIONS: Use typewriter or ball point pen. Please press firmly and print clearly. Please fill in blanks, underline or circle the correct answers. Send top three copies to Kansas Department of Health and Environment, Bureau of Water, Topeka, Kansas 66620-0001. Telephone: 785/296-3565. Send one to Water Well Owner and retain one for your records.