


1	LOCATION OF WATER WELL: County: <u>ELLIS</u>	Fraction <u>NE 1/4 SE 1/4 SW 1/4</u>	Section Number <u>33</u>	Township Number <u>13</u>	Range Number <u>18 W</u>
---	---	---	-----------------------------	------------------------------	-----------------------------

Distance and direction from nearest town or city street address of well if located within city?
1302 MAIN ST. Hays

2	WATER WELL OWNER: <u>Dan + Carol Schock</u> RR #, St. Address, Box #: <u>1302 MAIN</u> City, State, ZIP Code: <u>HAYS KS 67601</u>	Board of Agriculture, Division of Water Resources Application Number:
---	--	--

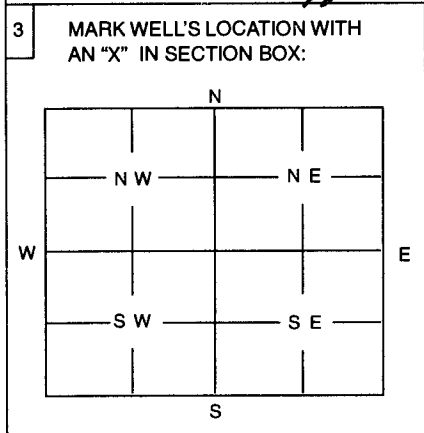

4 DEPTH OF WELL 30.6 ft bg1

WELL'S STATIC WATER LEVEL 26.83 ft. btoc

WELL WAS USED AS:

1 Domestic	5 Public Water Supply	9 Dewatering
2 Irrigation	6 Oil Field Water Supply	<u>10 Monitoring Well</u>
3 Feedlot	7 Domestic (Lawn & Garden)	11 Injection Well
4 Industrial	8 Air Conditioning	12 Other

Was a chemical / bacteriological sample submitted to Department? Yes No

If yes, mo/day/yr sample was submitted 6-25-15 for VOC's

Water Well Disinfected: Yes No Gasoline contamination present.

5 TYPE OF BLANK CASING USED:

1 Steel	3 RMP (SR)	5 Wrought	7 Fiberglass	9 Other (Specify below)
<u>2 PVC</u>	4 ABS	6 Asbestos-Cement	8 Concrete Tile

Blank casing diameter 2 in. Was casing pulled? Yes No If yes, how much -

Casing height above or below land surface 6 in.

6 GROUT PLUG MATERIAL: 1 Neat cement 2 Cement grout 3 Bentonite 4 Other Gravel to top of water

Grout Plug Intervals: From 30.6 ft. to 26 ft., From 26 ft. to 3 ft., From 3 to 0 ft.

What is the nearest source of possible contamination:

1 Septic tank	6 Seepage pit	<u>11 Fuel storage</u>	16 Other (specify below)
2 Sewer lines	7 Pit privy	12 Fertilizer storage
3 Watertight sewer lines	8 Sewage lagoon	13 Insecticide storage
4 Lateral lines	9 Feedyard	14 Abandoned water well
5 Cess Pool	10 Livestock pens	15 Oil well/Gas well

Direction from well? ~ 50' N. How many feet?

FROM	TO	PLUGGING MATERIALS
<u>30.6'</u>	<u>26'</u>	<u>1/4-1/2" gravel</u>
<u>26'</u>	<u>3'</u>	<u>Bentonite chips (later hydrated)</u>
<u>3</u>	<u>0</u>	<u>Soil & Concrete Walk.</u>

MW-4 plugged and abandoned in anticipation (July 2015) of Street and Walk renovation on 13th St.

7 CONTRACTOR'S OR LANDOWNER'S CERTIFICATION: This water well was plugged under my jurisdiction and was completed on (mo/day/year) 6-24-15 and this record is true to the best of my knowledge and belief. Kansas Water Well Record was completed on (mo/day/year) 6-25-15

Water Well Contractor's License No. under the business name of KDHE by (signature) [Signature]

This Water Well Record was completed on (mo/day/year) KDHE - N.W.D.O.

INSTRUCTIONS: Use typewriter or ball point pen. Please press firmly and print clearly. Please fill in blanks, underline or circle the correct answers. Send top three copies to Kansas Department of Health and Environment, Bureau of Water, Topeka, Kansas 66620-0001. Telephone: 785/296-3565. Send one to Water Well Owner and retain one for your records.