

WATER WELL PLUGGING RECORD

Form WWC-5P

KSA 82a-1212

ID No.


SVE-4

1 LOCATION OF WATER WELL:	Fraction	Section Number	Township Number	Range Number
County: Ellis	NE 1/4 SE 1/4 SE 1/4	33	13 S	18 W

Distance and direction from nearest town or city street address of well if located within city?
17th and Vine, Hays, KS

2 WATER WELL OWNER: Leroy Gottschalk
 RR#, St. Address, Box # PO Box 37
 City, State, ZIP Code Hays, KS 67601
 Board of Agriculture, Division of Water Resources
 Application Number:

3 MARK WELL'S LOCATION WITH AN "X" IN SECTION BOX:

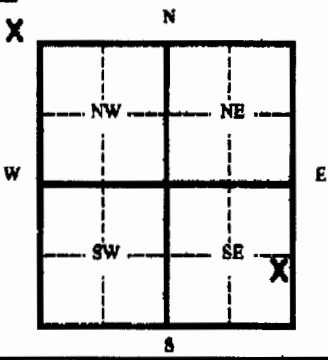

4 DEPTH OF WELL 17.4 ft.

WELL'S STATIC WATER LEVEL dry ft.

- WELL WAS USED AS:
- | | | |
|--------------|------------------------------|--------------------------------|
| 1 Domestic | 5 Public Water Supply | 9 Dewatering |
| 2 Irrigation | 6 Oil Field Water Supply | 10 Monitoring Well |
| 3 Feedlot | 7 Lawn and Garden (domestic) | 11 Injection Well |
| 4 Industrial | 8 Air Conditioning | 12 Other Soil Vapor Extraction |

Was a chemical/bacteriological sample submitted to Department? Yes No
 If yes, mo/day/yr sample was submitted
 Water Well Disinfected: Yes No

5 TYPE OF BLANK CASING USED:

1 Steel	3 RMP (SR)	5 Wrought	7 Fiberglass	9 Other (specify below)
2 PVC	4 ABC	6 Asbestos-Cement	8 Concrete Tile	

Blank casing diameter 2 in. Was casing pulled? Yes No X If yes, how much
 Casing height above or below land surface in.

6 GROUT PLUG MATERIAL: 1 Neat cement 2 Cement grout 3 Bentonite 4 Other
 Grout Plug Intervals From 0 ft. to 17.4 ft. From ft. to ft. From ft. to ft.

- What is the nearest source of possible contamination:
- | | | | |
|--------------------------|-------------------|-------------------------|--------------------------|
| 1 Septic tank | 6 Seepage pit | 11 Fuel storage | 16 Other (specify below) |
| 2 Sewer lines | 7 Pit privy | 12 Fertilizer storage | |
| 3 Watertight sewer lines | 8 Sewage lagoon | 13 Insecticide storage | |
| 4 Lateral lines | 9 Feedyard | 14 Abandoned water well | |
| 5 Cess Pool | 10 Livestock pens | 15 Oil well/ Gas well | |

Direction from well? How many feet?

FROM	TO	CODE	PLUGGING MATERIALS
0	1		concrete
1	17.4		Bentonite chips
			The ring remains, completion is concreted in. KDHE approved this method.

7 CONTRACTOR'S OR LANDOWNER'S CERTIFICATION: This water well was plugged under my jurisdiction and was completed on (mo/day/yr) 3/30/17 and this record is true to the best of my knowledge and belief. Kansas Water Well Contractor's License No. 4/10/17 This Water Well Record was completed on (mo/day/yr) under the business name of Bluestem Environmental Engineering, Inc. by (signature) under the business name of

INSTRUCTIONS: Please fill in blanks and circle the correct answers. Send three copies to Kansas Department of Health and Environment, Bureau of Water, 1000 S W Jackson St., Ste. 420, Topeka, Kansas 66620-0001. Telephone: 785-296-3585. Send one to Water Well Owner and retain one for your records.