

Revised

WATER WELL RECORD

Form WWC-5

Division of Water Resources App. No.


Well ID

MW10

Original Record [] Correction [X] Change in Well Use []

1 LOCATION OF WATER WELL: County Ellis, Fraction SW 1/4 NE 1/4 SE 1/4 SW 1/4, Section Number 33, Township Number T 13 S, Range Number R 18 E X W

2 WELL OWNER: Last Name: Business: E.H. Janzen, Address: 2608A Augusta Ln., City: Hays, State: KS, ZIP: 67601, Street or Rural Address where well is located: 107 13th St., Hays, KS

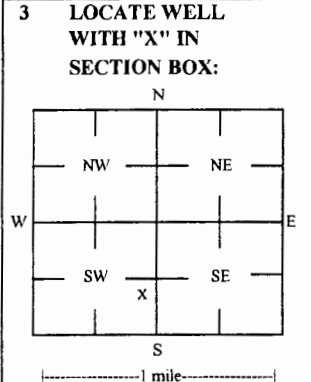

3 LOCATE WELL WITH 'X' IN SECTION BOX: 4 DEPTH OF COMPLETED WELL: 35 ft, Depth(s) Groundwater Encountered: 1) 35 ft, 2) 0 ft, 3) 0 ft, or 4) Dry Well, WELL'S STATIC WATER LEVEL: 24.35 ft, Pump test data: Well water was 0 ft after 0 hours pumping, gpm, Water well was 0 ft after 0 hours pumping, gpm, Estimated Yield: 0 gpm, Bore Hole Diameter: 7.25 in to 0 ft, and 0 in to 0 ft

5 Latitude: 38.87365 (decimal degrees), Longitude: 99.32884 (decimal degrees), Horizontal Datum: [X] WGS 84 [] NAD 83 [] NAD 27, Source for Latitude/Longitude: [] GPS (unit make/model:) (WAAS enabled? [] Yes [] No) [X] Land Survey [] Topographic Map [] Online Mapper

6 Elevation: 1996.55 ft [] Ground Level [X] TOC, Source: [X] Land Survey [] GPS [] Topographic Map [] Other

7 WELL WATER TO BE USED AS: 1 Domestic: [] Household [] Lawn & Garden [] Livestock [] Irrigation [] Feedlot [] Industrial, 2 Public Water Supply: well ID, 3 Dewatering: how many wells?, 4 Aquifer Recharge: well ID, 5 Monitoring: well ID MW10, 6 Environmental Remediation: well ID, 7 Air Sparge [] Soil Vapor Extractor [] Recovery [] Injection, 8 Oil Field Water Supply: lease, 9 Test Hole: well ID, [] Cased [] Uncased [] Geotechnical, 10 Geothermal: How many bores?, a) Closed Loop [] Horizontal [] Vertical, b) Open Loop [] Surface Discharge [] Inj. of Water [] Other (specify):

Was a chemical/bacteriological sample submitted to KDHE? [] Yes [X] No, If yes, date sample was submitted: , Water well disinfected? [] Yes [X] No

8 TYPE OF CASING USED: [] Steel [X] PVC [] Other, CASING JOINTS: [] Glued [] Clamped [] Welded [X] Threaded, Casing diameter: 2 in. to 20 ft, Diameter: in. to in., Casing height above land surface: -0.20 in., Weight: lbs./ft., Well thickness or gauge No: , TYPE OF SCREEN OR PERFORATION MATERIAL: [] Steel [] Stainless Steel [] Fiberglass [X] PVC [] Other (Specify) [] Brass [] Galvanized Steel [] Concrete tile [] None used (open hole), SCREEN OR PERFORATION OPENINGS ARE: [] Continuous Slot [X] Mill Slot [] Gauze Wrapped [] Torch Cut [] Drilled Holes [] Other (Specify) [] Louvered Shutter [] Key Punched [] Wire Wrapped [] Saw Cut [] None (Open Hole), SCREEN-PERFORATED INTERVALS: From 20 ft. to 35 ft., From ft. to ft., From ft. to ft., GRAVEL PACK INTERVALS: From 18 ft. to 35 ft., From ft. to ft., From ft. to ft.,

9 GROUT MATERIAL: [] Neat cement [] Cement grout [X] Bentonite [X] Other Concrete: 0-0.5', Grout intervals: From 0.5 ft. to 18 ft., From ft. to ft., From ft. to ft.,

Nearest source of possible contamination: [] Septic Tank [] Lateral Lines [] Pit Privy [] Livestock Pens [] Insecticide Storage [] Sewer Lines [] Cess Pool [] Sewage Lagoon [X] Fuel Storage [] Abandoned Water Well [] Watertight Sewer Lines [] Seepage Pit [] Feedyard [] Fertilizer Storage [] Oil Well / Gas Well [] Other (Specify): , Direction from well? NW, Distance from well? ~70 ft

Table with 6 columns: FROM, TO, LITHOLOGIC LOG, FROM, TO, LITHO. LOG (cont.) or PLUGGING INTERVALS. Rows include: 0 to 0.4 Asphalt, 0.4 to 2 Silty clay with trace sand and gravel, 2 to 4 Silty clay, 4 to 16 Silty shaley clay, 16 to 19 Fine grained sand, 19 to 35 Coarse grained sand.

Notes: KDHE ID: Don's 66; U6-026-00659, Target of monitoring well is shallow groundwater, <20' of grout was installed at the direction of KDHE.

11 CONTRACTOR'S OR LANDOWNER'S CERTIFICATION: This water well was [X] constructed, [] reconstructed, or [] plugged under my jurisdiction and was completed on (mo-day-year) 5/1/17 and this record is true to the best of my knowledge and belief, Kansas Water Well Contractor's License No. 757, This Water Well Record was completed on (mo-day-year) 7/12/17, under the business name of Larsen & Associates, Inc. Signature: [Signature]

Mail 1 white copy along with a fee of \$5.00 for each constructed well to: Kansas Department of Health and Environment, Bureau of Water, 1000 SW Jackson St., Suite 420, Topeka, Kansas 66612-1367. Mail one to Water Well Owner and retain one for your records. Telephone 785-296-5524. Visit us at http://www.kdheks.gov/waterwell/index.html KSA 82a-1212

Revised 7/10/2015