

WATER WELL RECORD

Form WWC-5

Division of Water Resources App. No.


Well ID

MW13

Original Record Correction Change in Well Use

1 LOCATION OF WATER WELL: County Ellis Fraction SE 1/4 NW 1/4 SE 1/4 SW 1/4 Section Number 33 Township Number T 13 S Range Number R 18 E W

2 WELL OWNER: Last Name: Business: E.H. Janzen Address: 2608A Augusta Ln. City Hays State: KS ZIP: 67601 Street or Rural Address where well is located (if unknown, distance and direction from nearest town or intersection): 105 W 12th St, Hays, KS 67601

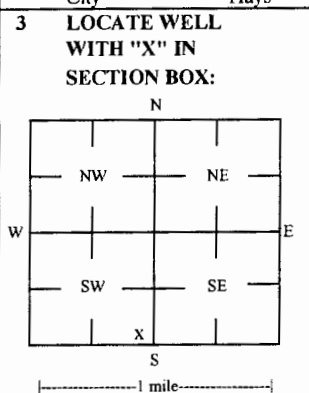

3 LOCATE WELL WITH 'X' IN SECTION BOX: 4 DEPTH OF COMPLETED WELL: 40 ft Depth(s) Groundwater Encountered: 1) ft 2) ft 3) ft, or 4) Dry Well WELL'S STATIC WATER LEVEL: 28.21 ft. X below land surface, measured on (mo-day-yr) 11/3/2017

5 Latitude: 38.87351 (decimal degrees) Longitude: 99.32982 (decimal degrees) Horizontal Datum: X WGS 84 NAD 83 NAD 27 Source for Latitude/Longitude: GPS (unit make/model) Land Survey Topographic Map Online Mapper

6 Elevation: 2001.69 ft Ground Level TOC Source: X Land Survey GPS Topographic Map Other

7 WELL WATER TO BE USED AS: 1 Domestic: Household Lawn & Garden Livestock Irrigation Feedlot Industrial 2 Public Water Supply: well ID 3 Dewatering: how many wells? 4 Aquifer Recharge: well ID 5 Monitoring: well ID MW13 6 Environmental Remediation: well ID 7 Air Sparge Soil Vapor Extractor Recovery Injection 8 Oil Field Water Supply: lease 9 Test Hole: well ID Cased Uncased Geotechnical 10 Geothermal: How many bores? a) Closed Loop Horizontal Vertical b) Open Loop Surface Discharge Inj. of Water Other (specify):

Was a chemical/bacteriological sample submitted to KDHE? Yes No If yes, date sample was submitted: Water well disinfected? Yes No

8 TYPE OF CASING USED: Steel PVC Other CASING JOINTS: Glued Clamped Welded Threaded Casing diameter 2 in. to 25 ft. Diameter in. to ft. Diameter in. to ft. Casing height above land surface -0.29 in. Weight lbs./ft. Well thickness or gauge No TYPE OF SCREEN OR PERFORATION MATERIAL: Steel Stainless Steel Fiberglass PVC Other (Specify) SCREEN OR PERFORATION OPENINGS ARE: Continuous Slot Mill Slot Gauze Wrapped Torch Cut Drilled Holes Other (Specify) Louvered Shutter Key Punched Wire Wrapped Saw Cut None (Open Hole) SCREEN-PERFORATED INTERVALS: From 25 ft. to 40 ft. GRAVEL PACK INTERVALS: From 23 ft. to 40 ft.

9 GROUT MATERIAL: Neat cement Cement grout Bentonite Other Concrete: 0-1' Grout intervals: From 1 ft. to 23 ft. From ft. to ft. From ft. to ft.

Nearest source of possible contamination: Septic Tank Lateral Lines Pit Privy Livestock Pens Insecticide Storage Sewer Lines Cess Pool Sewage Lagoon Fuel Storage Abandoned Water Well Watertight Sewer Lines Seepage Pit Feedyard Fertilizer Storage Oil Well / Gas Well Other (Specify) Direction from well? NE Distance from well? ~165 ft

Table with 6 columns: 10 FROM, TO, LITHOLOGIC LOG, FROM, TO, LITHO. LOG (cont.) or PLUGGING INTERVALS. Rows include Asphalt, Silty clay, Medium sand, Coarse sand and gravel.

Notes: KDHE ID: Don's 66: U6-026-00659 Target of monitoring well is shallow groundwater, <20' of grout was installed at the direction of KDHE.

11 CONTRACTOR'S OR LANDOWNER'S CERTIFICATION: This water well was constructed, reconstructed, or plugged under my jurisdiction and was completed on (mo-day-year) 11/2/17 and this record is true to the best of my knowledge and belief. Kansas Water Well Contractor's License No 757 This Water Well Record was completed on (mo-day-year) 11/28/17 under the business name of Larsen & Associates, Inc. Signature

Revised

SMH CONSULTANTS

November 09, 2016

Larsen & Associates
Jessica Chapman
1311 East 25th Street, Suite B
Lawrence, Kansas 66046
Email: Jess@LarsenEnvironmental.com

RE: Project No. 1711MN1324

Dear Jessica:

The following is the information requested on a Monitoring Well Site, Don's 66, 1302 Main, Hays, Ellis County, Kansas.

Point	North Coord.	East Coord.	Distance SE Cor. North	From S.33 West	Elev. Top Of Rim or PK Nail	Elev. Top of PVC Pipe	Latitude North	Longitude West
SE Corner S.33-T13S-R18W	10000	10000						
MW5R	10748.97	6967.62	748.97	3032.38	1994.83	1994.52	38.87308	99.32853
MW12	11067.22	6757.68	1067.22	3242.32	1997.72	1997.47	38.87396	99.32926
MW13	10903.84	6601.19	903.84	3398.81	2001.98	2001.69	38.87351	99.32982
MW14	10854.35	6935.21	854.35	3064.79	1995.45	1995.07	38.87337	99.32864
MW15	10717.37	6729.19	717.37	3270.81	1996.38	1996.06	38.87300	99.32937
Site BM	10926.69	6750.67	926.69	3249.33		BM Elevation = 1998.23		

BM Description:

MW5R, MW14, MW15 are in the: SW¼ NE¼ SE¼ SW¼ S.33-T13S-R18W
 MW2 is in the: NW¼ NE¼ SE¼ SW¼ S.33-T13S-R18W
 MW13 is in the: SE¼ NW¼ SE¼ SW¼ S.33-T13S-R18W

If you have any questions please do not hesitate in giving us a call.

Sincerely,



Tim Sloan, L.S.
SMH CONSULTANTS

RECEIVED

FEB 07 2017

BUREAU OF WATER

Revised: December 08, 2017