

WATER WELL PLUGGING RECORD Form WWC-5P

KSA 82a-1212

ID NO.

VP-4s/VP-4d


1 LOCATION OF WATER WELL: Fraction 1/4 NE 1/4 SE 1/4 SE 1/4 Section Number 28 Township Number 13 T S Range Number 18 E W
 County: Ellis

Street/Rural Address of Well Location; if unknown, distance & direction from nearest town or intersection: If at owner's address, check here 3501 N. Vine Street, Hays, Kansas

Global Positioning Systems (GPS) information:
 Latitude: 38.894817 (in decimal degrees)
 Longitude: 99.318543 (in decimal degrees)
 Elevation: 2047
 Horizontal Datum: WGS84, NAD83, NAD27
 Collection Method:

2 WATER WELL OWNER: Chevron EMC
 RR#, St. Address, Box #: 2300 Windy Ridge Way, Ste 800
 City, State ZIP Code: Atlanta, GA 30339

GPS unit (Make/Model: _____)
 Digital Map/Photo, Topographic Map, Land Survey
 Est. Accuracy: < 3 m, 3-5 m, 5-15 m, > 15 m

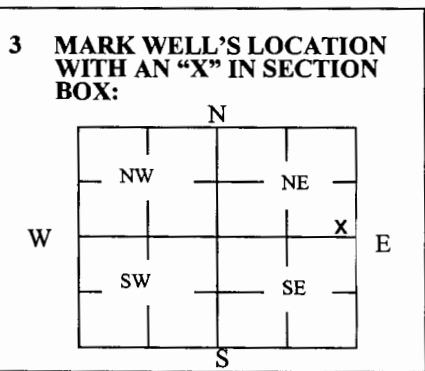

4 DEPTH OF WELL 5,10 ft.
 WELL'S STATIC WATER LEVEL N/A ft
 WELL WAS USED AS:
 Domestic Public Water Supply Dewatering
 Irrigation Oil Field Water Supply Monitoring
 Feedlot Domestic (Lawn & Garden) Injection Well
 Industrial Air Conditioning Other Vapor Well

Was a chemical/bacteriological sample submitted to Department? Yes No

5 TYPE OF BLANK CASING USED:

Steel RMP (SR) Wrought Fiberglass Other (Specify below) _____
 PVC ABS Asbestos-Cement Concrete Tile

Blank casing diameter 0.25 in. Was casing pulled? Yes No If yes, how much tubing removed _____
 Casing height above or below land surface N/A in.

6 GROUT PLUG MATERIAL: Neat cement Cement grout Bentonite Other _____

Grout Plug Intervals: From 10 ft. to 1 ft., From 5 ft. to 1 ft., From _____ ft. to _____ ft.

What is the nearest source of possible contamination:

Septic tank Seepage pit Fuel storage Other (specify below) _____
 Sewer lines Pit privy Fertilizer storage
 Watertight sewer lines Sewage lagoon Insecticide storage
 Lateral lines Feedyard Abandoned water well Direction from well? North
 Cess pool Livestock pens Oil well/Gas well How many feet? ~300 feet

FROM	TO	PLUGGING MATERIALS	FROM	TO	PLUGGING MATERIALS
10	1	bentonite	1	0	poured concrete
5	1	bentonite	1	0	poured concrete

7 CONTRACTOR'S OR LANDOWNER'S CERTIFICATION: This water well was plugged under my jurisdiction and was completed on (mo/day/year) 12/3/18 and this record is true to the best of my knowledge and belief. Kansas Water Well Contractor's License No. 891. This Water Well Record was completed on (mo/day/year) 12/21/18 under the business name of Job Site Services by (signature) [Signature]

Send one white copy to Kansas Department of Health & Environment, Geology Section, 1000 SW Jackson Street, Ste. 420, Topeka, KS 66612-1367. Send one copy to WATER WELL OWNER and retain one for your records.
 Visit us at <http://www.kdheks.gov/waterwell/index.html> Telephone 785-296-5524.