

WATER WELL PLUGGING RECORD Form WWC-5P

KSA 82a-1212

ID NO.

VP-2s/VP-2d


1 LOCATION OF WATER WELL: Fraction Section Number 28 Township Number 13 T S Range Number 18 E W
 County: Ellis

Street/Rural Address of Well Location; if unknown, distance & direction from nearest town or intersection: If at owner's address, check here 3501 N. Vine Street, Hays, Kansas

Global Positioning Systems (GPS) information:
 Latitude: 38.894722 (in decimal degrees)
 Longitude: 99.318543 (in decimal degrees)
 Elevation: 2046
 Horizontal Datum: WGS84, NAD83, NAD27
 Collection Method:

2 WATER WELL OWNER: Chevron EMC
 RR#, St. Address, Box #: 2300 Windy Ridge Way, Ste 800
 City, State ZIP Code: Atlanta, GA 30339

GPS unit (Make/Model:)
 Digital Map/Photo, Topographic Map, Land Survey
 Est. Accuracy: < 3 m, 3-5 m, 5-15 m, > 15 m

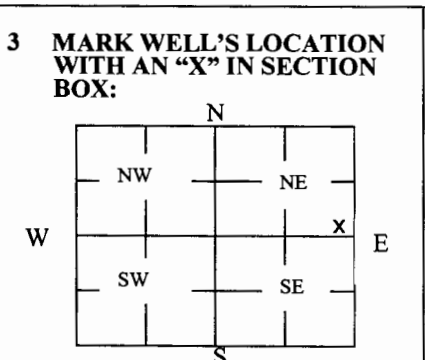

4 DEPTH OF WELL 5,10 ft.
 WELL'S STATIC WATER LEVEL N/A ft
 WELL WAS USED AS:
 Domestic Public Water Supply Dewatering
 Irrigation Oil Field Water Supply Monitoring
 Feedlot Domestic (Lawn & Garden) Injection Well
 Industrial Air Conditioning Other

Was a chemical/bacteriological sample submitted to Department? Yes No

5 TYPE OF BLANK CASING USED:

Steel RMP (SR) Wrought Fiberglass Other (Specify below)
 PVC ABS Asbestos-Cement Concrete Tile

Blank casing diameter 0.25 in. Was casing pulled? Yes No If yes, how much tubing removed
 Casing height above or below land surface N/A in.

6 GROUT PLUG MATERIAL: Neat cement Cement grout Bentonite Other

Grout Plug Intervals: From 10 ft. to 1 ft., From 5 ft. to 1 ft., From ft. to ft.

What is the nearest source of possible contamination:
 Septic tank Seepage pit Fuel storage Other (specify below)
 Sewer lines Pit privy Fertilizer storage
 Watertight sewer lines Sewage lagoon Insecticide storage
 Lateral lines Feedyard Abandoned water well
 Cess pool Livestock pens Oil well/Gas well

Direction from well? North
 How many feet? ~300 feet

FROM	TO	PLUGGING MATERIALS	FROM	TO	PLUGGING MATERIALS
10	1	bentonite	1	0	poured concrete
5	1	bentonite	1	0	poured concrete

7 CONTRACTOR'S OR LANDOWNER'S CERTIFICATION: This water well was plugged under my jurisdiction and was completed on (mo/day/year) 12/3/18 and this record is true to the best of my knowledge and belief. Kansas Water Well Contractor's License No. 891. This Water Well Record was completed on (mo/day/year) 12/21/18 under the business name of Job Site Services by (signature) [Signature]

Send one white copy to Kansas Department of Health & Environment, Geology Section, 1000 SW Jackson Street, Ste. 420, Topeka, KS 66612-1367. Send one copy to WATER WELL OWNER and retain one for your records.
 Visit us at <http://www.kdheks.gov/waterwell/index.html> Telephone 785-296-5524.