

**WATER WELL PLUGGING RECORD Form WWC-5P**

KSA 82a-1212

ID NO.

MW-13


**1 LOCATION OF WATER WELL:** County: Ellis Fraction - ¼ NE ¼ SE ¼ SE ¼ Section Number 28 Township Number 13 T S Range Number 18  E  W

Street/Rural Address of Well Location; if unknown, distance & direction from nearest town or intersection: If at owner's address, check here  3501 N. Vine Street, Hays, Kansas

**Global Positioning Systems (GPS) information:**  
 Latitude: 38.89473 (in decimal degrees)  
 Longitude: 99.31812 (in decimal degrees)  
 Elevation: 2047  
 Horizontal Datum:  WGS84,  NAD83,  NAD27  
 Collection Method:

**2 WATER WELL OWNER:** Chevron EMC  
 RR#, St. Address, Box #: 2300 Windy Ridge Way, Ste 800  
 City, State ZIP Code: Atlanta, GA 30339

GPS unit (Make/Model: \_\_\_\_\_)  
 Digital Map/Photo,  Topographic Map,  Land Survey  
 Est. Accuracy:  < 3 m,  3-5 m,  5-15 m,  > 15 m

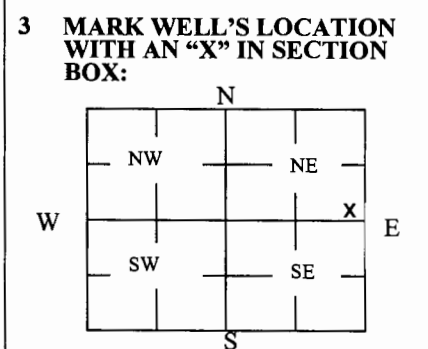

**4 DEPTH OF WELL** 29.5 ft.  
 WELL'S STATIC WATER LEVEL 18.75 ft  
 WELL WAS USED AS:  
 Domestic  Public Water Supply  Dewatering  
 Irrigation  Oil Field Water Supply  Monitoring  
 Feedlot  Domestic (Lawn & Garden)  Injection Well  
 Industrial  Air Conditioning  Other \_\_\_\_\_  
 Was a chemical/bacteriological sample submitted to Department? Yes  No

**5 TYPE OF BLANK CASING USED:**

Steel  RMP (SR)  Wrought  Fiberglass  Other (Specify below) \_\_\_\_\_  
 PVC  ABS  Asbestos-Cement  Concrete Tile

Blank casing diameter 2 in. Was casing pulled? Yes  No  If yes, how much \_\_\_\_\_  
 Casing height above or below land surface 36 below in.

**6 GROUT PLUG MATERIAL:**  Neat cement  Cement grout  Bentonite  Other \_\_\_\_\_

Grout Plug Intervals: From 29.5 ft. to 3 ft., From \_\_\_\_\_ ft. to \_\_\_\_\_ ft., From \_\_\_\_\_ ft. to \_\_\_\_\_ ft.

What is the nearest source of possible contamination:

Septic tank  Seepage pit  Fuel storage  Other (specify below) \_\_\_\_\_  
 Sewer lines  Pit privy  Fertilizer storage  
 Watertight sewer lines  Sewage lagoon  Insecticide storage  
 Lateral lines  Feedyard  Abandoned water well Direction from well? North  
 Cess pool  Livestock pens  Oil well/Gas well How many feet? ~300 feet

FROM	TO	PLUGGING MATERIALS	FROM	TO	PLUGGING MATERIALS
29.5	3	bentonite medium chip	3	0.5	crushed concrete/sand
0.5	0	poured concrete			

**7 CONTRACTOR'S OR LANDOWNER'S CERTIFICATION:** This water well was plugged under my jurisdiction and was completed on (mo/day/year) 12/3/18 and this record is true to the best of my knowledge and belief. Kansas Water Well Contractor's License No. 891. This Water Well Record was completed on (mo/day/year) 12/2/18 under the business name of Job Site Services by (signature) \_\_\_\_\_

Send one white copy to Kansas Department of Health & Environment, Geology Section, 1000 SW Jackson Street, Ste. 420, Topeka, KS 66612-1367. Send one copy to WATER WELL OWNER and retain one for your records.  
 Visit us at <http://www.kdheks.gov/waterwell/index.html> Telephone 785-296-5524.