

**WATER WELL PLUGGING RECORD Form WWC-5P**

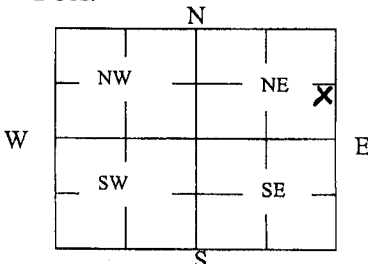
KSA 82a-1212 ID NO.

MW - 45

<b>1 LOCATION OF WATER WELL:</b> County: Ellis	Fraction NE ¼ NE ¼ SE ¼ NE ¼	Section Number 28	Township Number T 13 S	Range Number 18 <input type="checkbox"/> E <input checked="" type="checkbox"/> W
---	---------------------------------	----------------------	---------------------------	---

Street/Rural Address of Well Location; if unknown, distance & direction from nearest town or intersection: If at owner's address, check here <input type="checkbox"/> 3601 Vine, Hays KS	<b>Global Positioning Systems (GPS) information:</b> Latitude: 38.895601 (in decimal degrees) Longitude: -99.317987 (in decimal degrees) Elevation: T.O.C. Damaged (approx.: 2045.63') Horizontal Datum: <input checked="" type="checkbox"/> WGS84, <input type="checkbox"/> NAD83, <input type="checkbox"/> NAD27 Collection Method:
--	--

<b>2 WATER WELL OWNER:</b> BP Products North America Inc RR#, St. Address, Box #: P.O. Box# 15748 City, State ZIP Code: Shawnee Mission, KS 66285	<input checked="" type="checkbox"/> GPS unit (Make/Model: <u>Garmin Etrex 10</u> ) <input type="checkbox"/> Digital Map/Photo, <input type="checkbox"/> Topographic Map, <input type="checkbox"/> Land Survey Est. Accuracy: <input checked="" type="checkbox"/> < 3 m, <input type="checkbox"/> 3-5 m, <input type="checkbox"/> 5-15 m, <input type="checkbox"/> > 15 m
---	--

<b>3 MARK WELL'S LOCATION WITH AN "X" IN SECTION BOX:</b> 	<b>4 DEPTH OF WELL</b> <u>30</u> ft. WELL'S STATIC WATER LEVEL <u>Unknown</u> ft. WELL WAS USED AS: <input type="checkbox"/> Domestic <input type="checkbox"/> Public Water Supply <input type="checkbox"/> Dewatering <input type="checkbox"/> Irrigation <input type="checkbox"/> Oil Field Water Supply <input checked="" type="checkbox"/> Monitoring <input type="checkbox"/> Feedlot <input type="checkbox"/> Domestic (Lawn & Garden) <input type="checkbox"/> Injection Well <input type="checkbox"/> Industrial <input type="checkbox"/> Air Conditioning <input type="checkbox"/> Other _____ Was a chemical/bacteriological sample submitted to Department? Yes <input type="checkbox"/> No <input checked="" type="checkbox"/>
--	---

**5 TYPE OF BLANK CASING USED:**

Steel  RMP (SR)  Wrought  Fiberglass  Other (Specify below) \_\_\_\_\_  
 PVC  ABS  Asbestos-Cement  Concrete Tile

Blank casing diameter 2 in. Was casing pulled? Yes  No  If yes, how much NA  
 Casing height above or below land surface Damaged in.

**6 GROUT PLUG MATERIAL:**  Neat cement  Cement grout  Bentonite  Other Bentonite Chips

Grout Plug Intervals: From 30 ft. to 3 ft., From \_\_\_\_\_ ft. to \_\_\_\_\_ ft., From \_\_\_\_\_ ft. to \_\_\_\_\_ ft.

What is the nearest source of possible contamination:  
 Septic tank  Seepage pit  Fuel storage  Other (specify below) UST Dispensers  
 Sewer lines  Pit privy  Fertilizer storage  
 Watertight sewer lines  Sewage lagoon  Insecticide storage  
 Lateral lines  Feedyard  Abandoned water well Direction from well? West  
 Cess pool  Livestock pens  Oil well/Gas well How many feet? Approx.: 60ft

FROM	TO	PLUGGING MATERIALS	FROM	TO	PLUGGING MATERIALS
30ft bgs	3ft bgs	Bentonite Chips			

**7 CONTRACTOR'S OR LANDOWNER'S CERTIFICATION:** This water well was plugged under my jurisdiction and was completed on (mo/day/year) 06/09/2020 and this record is true to the best of my knowledge and belief. Kansas Water Well Contractor's License No. KDHE-NWDO. This Water Well Record was completed on (mo/day/year) 06/09/2020 under the business name of Kansas Department of Health & Environment by (signature) [Signature]

Send one white copy to Kansas Department of Health & Environment, Geology Section, 1000 SW Jackson Street, Ste. 420, Topeka, KS 66612-1367. Send one copy to WATER WELL OWNER and retain one for your records.  
 Visit us at <http://www.kdheks.gov/waterwell/index.html> Telephone 785-296-5524.