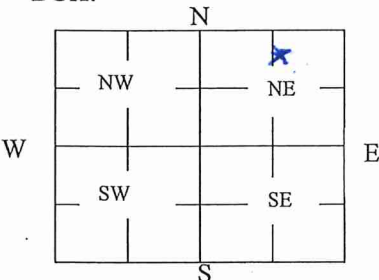


## WATER WELL PLUGGING RECORD Form WWC-5P

KSA 82a-1212

ID NO.

Mw-37

<b>1 LOCATION OF WATER WELL:</b> County: <u>ELLIS</u> Street/Rural Address of Well Location; if unknown, distance & direction from nearest town or intersection: If at owner's address, check here <input type="checkbox"/> <u>W 25 TH ST Hwy and Main St, Hays KS</u>	Fraction <u>SW 1/4 NW 1/4 NE 1/4 NE 1/4</u> Section Number <u>33</u> Township Number <u>13</u> S Range Number <u>18</u> E <input checked="" type="checkbox"/> W	<b>Global Positioning Systems (GPS) information:</b> Latitude: <u>38.88404</u> (in decimal degrees) Longitude: <u>-99.32233</u> (in decimal degrees) Elevation: <u>2021</u> Horizontal Datum: <input checked="" type="checkbox"/> WGS84, <input type="checkbox"/> NAD83, <input type="checkbox"/> NAD27 Collection Method: <input checked="" type="checkbox"/> GPS unit (Make/Model: <u>GARMIN GPS 72</u> ) <input type="checkbox"/> Digital Map/Photo, <input type="checkbox"/> Topographic Map, <input type="checkbox"/> Land Survey Est. Accuracy: <input checked="" type="checkbox"/> < 3 m, <input type="checkbox"/> 3-5 m, <input type="checkbox"/> 5-15 m, <input type="checkbox"/> > 15 m	
<b>2 WATER WELL OWNER:</b> <u>BROWN'S SERVICE CTR</u> RR#, St. Address, Box #: <u>2701 VINE ST.</u> City, State ZIP Code: <u>HAYS, KS 67601</u>	<b>3 MARK WELL'S LOCATION WITH AN "X" IN SECTION BOX:</b> <div style="text-align: center;">  </div>	
<b>4 DEPTH OF WELL</b> <u>LOG = 79</u> ft. <u>Measured @ 70.2' b TOC 11/2/2024</u> WELL'S STATIC WATER LEVEL <u>36.6</u> ft <u>b TOC</u> WELL WAS USED AS: <input type="checkbox"/> Domestic <input type="checkbox"/> Public Water Supply <input type="checkbox"/> Dewatering <u>INSTALLED</u> <input type="checkbox"/> Irrigation <input type="checkbox"/> Oil Field Water Supply <input checked="" type="checkbox"/> Monitoring <u>10/08/2002</u> <input type="checkbox"/> Feedlot <input type="checkbox"/> Domestic (Lawn & Garden) <input type="checkbox"/> Injection Well <input type="checkbox"/> Industrial <input type="checkbox"/> Air Conditioning <input type="checkbox"/> Other _____ Was a chemical/bacteriological sample submitted to Department? Yes <input type="checkbox"/> No <input checked="" type="checkbox"/> <u>State of KS SITE ID Number 00353544</u>	
<b>5 TYPE OF BLANK CASING USED:</b> <input type="checkbox"/> Steel <input type="checkbox"/> RMP (SR) <input type="checkbox"/> Wrought <input type="checkbox"/> Fiberglass <input type="checkbox"/> Other (Specify below) <input checked="" type="checkbox"/> PVC <input type="checkbox"/> ABS <input type="checkbox"/> Asbestos-Cement <input type="checkbox"/> Concrete Tile Blank casing diameter <u>2</u> in. Was casing pulled? Yes <input checked="" type="checkbox"/> No <input type="checkbox"/> If yes, how much <u>7.2</u> Cut off @ base of Casing height above or below land surface <u>4</u> in. <u>Trench for new sanitary sewer</u>	
<b>6 GROUT PLUG MATERIAL:</b> <input type="checkbox"/> Neat cement <input type="checkbox"/> Cement grout <input checked="" type="checkbox"/> Bentonite <input type="checkbox"/> Other _____ Grout Plug Intervals: From <u>70.2</u> ft. to <u>7.3</u> ft., <u>[From 7.3 ft. to 0 ft.]</u> From _____ ft. to _____ ft. <u>Soil/Sewer line trench</u> What is the nearest source of possible contamination: <input type="checkbox"/> Septic tank <input type="checkbox"/> Seepage pit <input type="checkbox"/> Fuel storage <input type="checkbox"/> Other (specify below) <input checked="" type="checkbox"/> Sewer lines <input type="checkbox"/> Pit privy <input type="checkbox"/> Fertilizer storage <input type="checkbox"/> Watertight sewer lines <input type="checkbox"/> Sewage lagoon <input type="checkbox"/> Insecticide storage <input type="checkbox"/> Lateral lines <input type="checkbox"/> Feedyard <input type="checkbox"/> Abandoned water well Direction from well? <u>Over top of cut</u> <input type="checkbox"/> Cess pool <input type="checkbox"/> Livestock pens <input type="checkbox"/> Oil well/Gas well How many feet? <u>Casing</u>	
<table border="1" style="width:100%; border-collapse: collapse;"> <thead> <tr> <th>FROM</th> <th>TO</th> <th>PLUGGING MATERIALS</th> <th>FROM</th> <th>TO</th> <th>PLUGGING MATERIALS</th> </tr> </thead> <tbody> <tr> <td><u>70.2'</u></td> <td><u>7.3'</u></td> <td><u>3/8" Hole Plug Bentonite</u></td> <td></td> <td></td> <td></td> </tr> <tr> <td><u>7.3'</u></td> <td><u>0'</u></td> <td><u>Soil/Trench backfill for New Sanitary Sewer line (ASTRA Bank)</u></td> <td></td> <td></td> <td></td> </tr> <tr><td> </td><td> </td><td> </td><td> </td><td> </td><td> </td></tr> <tr><td> </td><td> </td><td> </td><td> </td><td> </td><td> </td></tr> <tr><td> </td><td> </td><td> </td><td> </td><td> </td><td> </td></tr> <tr><td> </td><td> </td><td> </td><td> </td><td> </td><td> </td></tr> <tr><td> </td><td> </td><td> </td><td> </td><td> </td><td> </td></tr>
<b>7 CONTRACTOR'S OR LANDOWNER'S CERTIFICATION:</b> This water well was plugged under my jurisdiction and was completed on (mo/day/year) <u>11-21-2024</u> and this record is true to the best of my knowledge and belief. Kansas Water Well Contractor's License No. <u>KDHE</u> . This Water Well Record was completed on (mo/day/year) <u>12-3-2024</u> under the business name of <u>KDHE</u> by (signature) <u>Bill Thimann</u>	

Send one white copy to Kansas Department of Health & Environment, Geology Section, 1000 SW Jackson Street, Ste. 420, Topeka, KS 66612-1367. Send one copy to WATER WELL OWNER and retain one for your records.


Visit us at <http://www.kdheks.gov/waterwell/index.html> Telephone 785-296-5524.

KSA82a-1212

Revised 1/20/2015

*PID - Photoionization Detector*

## T.13 R.18W Sec.33 Ellis County

 <b>Bluestem Environmental Engineering, Inc.</b>							LOG OF BORING NO.: <b>MW-37</b>		SHEET NUMBER 2 of 2	
CLIENT: <b>Brown's Service Center</b>							GEOLOGIST: <b>Keith Reavis</b>			
PROJECT NAME: <b>Brown's Service Center</b>							DATE: <b>10/09/02</b>			
							PROJECT NUMBER: <b>U6-026-00677</b>			
SAMPLER TYPE	SAMPLE DEPTH	PID (PPM)	RECOVERY (FT)	DEPTH IN FEET	USCS CLASS	C I	SOIL DESCRIPTION AND DRILLING CONDITIONS	NOTES:		
SS	40-42	ND		42			Light pink to red silty CLAY to clayey SILT, Very sandy CLAY to fine to medium grained clayey SAND, wet, soft, cohesive			
				44						
SS	45-47	NT		46						
				48						
				50						
SS	50-52	NT		52						
				54			Tan CLAY, dense, slightly sandy			
				56						
				58						
				60						
SS	60-62	NT		62						
				64			SAND and GRAVEL, clayey, wet, loose			
				66						
				68						
				70						
				72			Tan sandy CLAY	Bent grout from 2 to 50' Gravel pack 50 to 79' 2" screen from 64 to 79'		
				74			SAND and GRAVEL, loose			
				76						
				78			Blue to black SHALE			
				80			Bottom of Boring = 79 Feet  <div style="text-align: center;"> <b>RECEIVED</b>  <b>DEC 09 2024</b>  <b>BUREAU OF WATER</b> </div>			
				82						
				84						
				86						
				88						
				90						

## LEGEND:

SS - Split Spoon

CS - 5 foot CME Sampler

ST - Shelby Tube

PP - Pocket Penetrometer

PID - Photoionization Detector





Bluestem Environmental Engineering, Inc.

Figure 1.2

Site Aerial Photograph

Brown's Service Center, Hays, Kansas

RECEIVED

DEC 09 2024

BUREAU OF WATER

Drawn By: PMG	Date: 6/13/02	Rev: 0	Date: 11/20/02
Reviewed By: Patrick M. Goeke, P.E.	KDHE Code: U6-026-00676		
Scale: 1 inch = 200 feet	File: aerial.dwg		



ZERR ENGINEERING

Date: 11-07-2002

Project No. 02-118

Page 2 of 2

OUTLYING WELLS  
Hays, Kansas

Well Designation	Coordinates *	Elevation **	Top of N Edge	
			Top of Casing	Flush Mount Ring
MW - 37	37691.36657	28880.31110	2019.37	2019.71
MW - 38	37710.55838	28366.21689	2023.94	2024.44
MW - 39	38123.03762	29963.31547	2036.83	2037.08

\* Assumes the Coordinates of the NE Corner of 33-13-18 to be N = 38202.38565, E = 30176.39037

\*\* Originating Bench Mark: USGS N 267 Elevation = 1988.60

*Brown's Service Co.  
2701 Vine St, HAYS.*

Well Designation	Tag I.D. No.	Distance From NE Corner of 33-13-18		2.5 Acre Tract Location
		South	West	
✓ MW - 37	00353544	538	1285	SW NW NE NE
MW - 38	00353537	529	1800	SE NE NW NE
MW - 39	00353551	84	211	NE NE NE NE

RECEIVED

DEC 09 2024

BUREAU OF WATER

