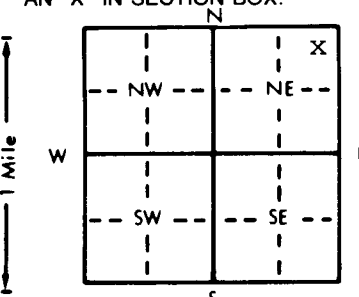


1 LOCATION OF WATER WELL: County: <u>Ellis</u>	Fraction <u>NE 1/4 NE 1/4 NE 1/4</u>	Section Number <u>35</u>	Township Number <u>T 13 S</u>	Range Number <u>R 18 E/W</u>
---	---	-----------------------------	----------------------------------	---------------------------------

Distance and direction from nearest town or city street address of well if located within city?
1 mile east of 27th and Canterbury Road in Hays, Kansas

2 WATER WELL OWNER: Keith Clark
 RR#, St. Address, Box # : Catherine Route Board of Agriculture, Division of Water Resources
 City, State, ZIP Code : Hays, Kansas 67601 Application Number:

3 LOCATE WELL'S LOCATION WITH AN "X" IN SECTION BOX: 	4 DEPTH OF COMPLETED WELL: <u>15</u> ft. ELEVATION: <u>Valley</u> Depth(s) Groundwater Encountered 1. <u>12</u> ft. 2. _____ ft. 3. _____ ft. WELL'S STATIC WATER LEVEL <u>12</u> ft. below land surface measured on <u>mo/day/yr</u> <u>7/29/94</u> Pump test data: Well water was <u>12</u> ft. after <u>3</u> hours pumping <u>40</u> gpm Est. Yield _____ gpm: Well water was _____ ft. after _____ hours pumping _____ gpm Bore Hole Diameter <u>8</u> in. to <u>15</u> ft., and _____ in. to _____ ft. WELL WATER TO BE USED AS: 5 Public water supply 8 Air conditioning 11 Injection well <u>1 Domestic</u> 3 Feedlot 6 Oil field water supply 9 Dewatering 12 Other (Specify below) 2 Irrigation 4 Industrial 7 Lawn and garden only 10 Monitoring well Was a chemical/bacteriological sample submitted to Department? Yes _____ No _____; if yes, mo/day/yr sample was submitted _____ Water Well Disinfected? Yes <input checked="" type="checkbox"/> No _____
--	---

5 TYPE OF BLANK CASING USED:
 1 Steel 3 RMP (SR) 5 Wrought iron 8 Concrete tile CASING JOINTS: Glued _____ Clamped _____
 2 PVC 4 ABS 6 Asbestos-Cement 9 Other (specify below) Welded _____
 7 Fiberglass _____ Threaded _____
 Blank casing diameter 5 in. to _____ ft., Dia _____ in. to _____ ft., Dia _____ in. to _____ ft.
 Casing height above land surface 36 in., weight _____ lbs./ft. Wall thickness or gauge No. _____
 TYPE OF SCREEN OR PERFORATION MATERIAL:
 1 Steel 3 Stainless steel 5 Fiberglass 7 PVC 10 Asbestos-cement
 2 Brass 4 Galvanized steel 6 Concrete tile 8 RMP (SR) 11 Other (specify) NA
 9 ABS 12 None used (open hole)
 SCREEN OR PERFORATION OPENINGS ARE:
 1 Continuous slot 3 Mill slot 5 Gauzed wrapped 8 Saw cut 11 None (open hole)
 2 Louvered shutter 4 Key punched 6 Wire wrapped 9 Drilled holes
 7 Torch cut 10 Other (specify) NA
 SCREEN-PERFORATED INTERVALS: From NA ft. to NA ft., From _____ ft. to _____ ft.
 From _____ ft. to _____ ft., From _____ ft. to _____ ft.
 GRAVEL PACK INTERVALS: From _____ ft. to _____ ft., From _____ ft. to _____ ft.
 From _____ ft. to _____ ft., From _____ ft. to _____ ft.

6 GROUT MATERIAL: 3 1 Neat cement 2 Cement grout 3 Bentonite 4 Other _____
 Grout intervals: From 11 ft. to 6 ft., From _____ ft. to _____ ft., From _____ ft. to _____ ft.
 What is the nearest source of possible contamination:
 1 Septic tank 4 Lateral lines 7 Pit privy 10 Livestock pens 14 Abandoned water well
 2 Sewer lines 5 Cess pool 8 Sewage lagoon 11 Fuel storage 15 Oil well/Gas well
 3 Watertight sewer lines 6 Seepage pit 9 Feedyard 12 Fertilizer storage 16 Other (specify below)
 13 Insecticide storage _____
 Direction from well? _____ How many feet? _____

FROM	TO	LITHOLOGIC LOG	FROM	TO	PLUGGING INTERVALS
15	11	Gravel			
11	6	Expanding Bentonite pellets			
6	3	Compacted clay			
3	0	Surface silts and clay			
Pumped water well to waste for three hours at a rate of 40 g.p.m. Recirculated with heavy chlorine solution. Removed concrete pad. Removed well casing. Filled to static water level with well pack. Pumped off excess head. Placed expanding Bentonite pellets to six feet. Filled remainder of hole with compacted clays and surface silts.					

7 CONTRACTOR'S OR LANDOWNER'S CERTIFICATION: This water well was (1) constructed, (2) reconstructed, or (3) plugged under my jurisdiction and was completed on (mo/day/year) 7/29/94 and this record is true to the best of my knowledge and belief. Kansas Water Well Contractor's License No. 199 This Water Well Record was completed on (mo/day/yr) 8/25/94 under the business name of Karst Water Well Drilling & Service, Inc. by (signature) [Signature]

OFFICE USE ONLY
T
R
EW
SEC.
1/4
1/4
1/4