


1 LOCATION OF WATER WELL: County: Ehhis Fraction: 3C 1/4 SW 1/4 SW 1/4 Section Number: 35 Township Number: T 13 S Range Number: R 18 EW

Distance and direction from nearest town or city street address of well if located within city?  
1300 Harvest Rd. Hays Ks.

2 WATER WELL OWNER: Agape Southern Baptist Church Inc.  
 RR#, St. Address, Box #: P.O. Box 644  
 City, State, ZIP Code: Hays Ks. 67601-0664  
 Board of Agriculture, Division of Water Resources  
 Application Number:

3 LOCATE WELL'S LOCATION WITH AN "X" IN SECTION BOX:

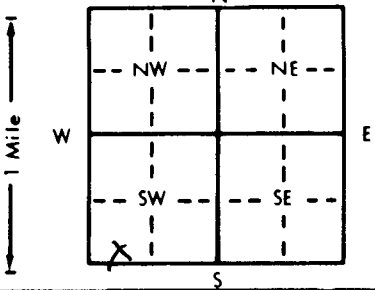

4 DEPTH OF COMPLETED WELL: 60 ft. ELEVATION:  
 Depth(s) Groundwater Encountered 1. 36 ft. 2. ft. 3. ft.  
 WELL'S STATIC WATER LEVEL: 36 ft. below land surface measured on mo/day/yr 10/5/94  
 Pump test data: Well water was 12 ft. after 3.5 hours pumping 10 gpm  
 Est. Yield 10 gpm: Well water was ft. after hours pumping gpm  
 Bore Hole Diameter: 1.0 in. to ft., and in. to ft.  
 WELL WATER TO BE USED AS:  
 Domestic 3 Feedlot 6 Oil field water supply 9 Dewatering 12 Other (Specify below)  
 Irrigation 4 Industrial 7 Lawn and garden only 10 Monitoring well  
 Was a chemical/bacteriological sample submitted to Department? Yes No; If yes, mo/day/yr sample was submitted  
 Water Well Disinfected?  Yes No

5 TYPE OF BLANK CASING USED:  
 1 Steel 3 RMP (SR) 5 Wrought iron 8 Concrete tile CASING JOINTS:  Glued  Clamped  
 2 PVC 4 ABS 6 Asbestos-Cement 9 Other (specify below)  Welded  
 7 Fiberglass  Threaded

Blank casing diameter: 5 in. to ft., Dia. in. to ft., Dia. in. to ft.  
 Casing height above land surface: 24 in., weight lbs./ft. Wall thickness or gauge No. SDR-26

TYPE OF SCREEN OR PERFORATION MATERIAL:  
 1 Steel 3 Stainless steel 5 Fiberglass  7 PVC 10 Asbestos-cement  
 2 Brass 4 Galvanized steel 6 Concrete tile  8 RMP (SR) 11 Other (specify)  
 12 None used (open hole)

SCREEN OR PERFORATION OPENINGS ARE:  
 1 Continuous slot  3 Mill slot 5 Gauzed wrapped 8 Saw cut 11 None (open hole)  
 2 Louvered shutter 4 Key punched 6 Wire wrapped 9 Drilled holes  
 7 Torch cut 10 Other (specify)

SCREEN-PERFORATED INTERVALS: From 40 ft. to 60 ft., From ft. to ft.  
 GRAVEL PACK INTERVALS: From 35 ft. to 60 ft., From ft. to ft.

6 GROUT MATERIAL: 1 Neat cement  2 Cement grout 3 Bentonite 4 Other  
 Grout Intervals: From 4 ft. to 24 ft., From ft. to ft., From ft. to ft.

What is the nearest source of possible contamination:  
 1 Septic tank 4 Lateral lines 7 Pit privy 10 Livestock pens 14 Abandoned water well  
 2 Sewer lines 5 Cess pool 8 Sewage lagoon 11 Fuel storage 15 Oil well/Gas well  
 3 Watertight sewer lines 6 Seepage pit 9 Feedyard 12 Fertilizer storage 16 Other (specify below)  
 13 Insecticide storage  
 Direction from well? West How many feet? 50-100'

FROM	TO	LITHOLOGIC LOG	FROM	TO	PLUGGING INTERVALS
0	10	Top soil			
10	36	brown clay			
36	48	fine grey sand			
48	58	brown clay m/x with grey sand			
58	60	shale			

7 CONTRACTOR'S OR LANDOWNER'S CERTIFICATION: This water well was  (1) constructed, (2) reconstructed, or (3) plugged under my jurisdiction and was completed on (mo/day/year) 10/5/94 and this record is true to the best of my knowledge and belief. Kansas Water Well Contractor's License No. 4426 This Water Well Record was completed on (mo/day/yr) 10/5/94 under the business name of 4426 Water Well Drilling by (signature) Johnstone