WATER WELL RECORD Form WWC-5 KSA 82a-1212 2283.03, 4220.03-MW-10

1 LOCATION OF WATER WELL: County: ELLIS | Fraction: SE ¼ SE ¼ NE ¼ | Section Number: 28 | Township Number: T 13 S | Range Number: R 18 E (W)

Distance and direction from nearest town or city street address of well if located within city?
95.0 FEET WEST OF 3203 NORTH VINE, HAYS, KANSAS

2 WATER WELL OWNER: TEXACO REFINING & MARKETING, INC.
RR#, St. Address, Box # : 1437 SOUTH BOULDER
City, State, ZIP Code : TULSA, OK 74119
Board of Agriculture, Division of Water Resources
Application Number:

3 LOCATE WELL'S LOCATION WITH AN "X" IN SECTION BOX:

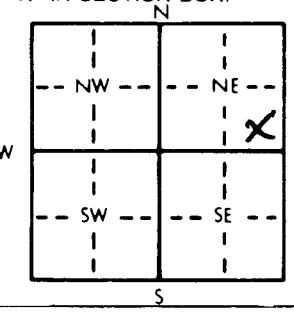

4 DEPTH OF COMPLETED WELL 24.80 ft. ELEVATION: 2017.0
Depth(s) Groundwater Encountered 1. 18.0 ft. 2. ft. 3. ft.
WELL'S STATIC WATER LEVEL 20.10 ft. below land surface measured on mo/day/yr 12/15/94
Pump test data: Well water was ft. after hours pumping gpm
Est. Yield gpm: Well water was ft. after hours pumping gpm
Bore Hole Diameter 8 1/4 in. to 30.0 ft., and in. to ft.
WELL WATER TO BE USED AS: 5 Public water supply 8 Air conditioning 11 Injection well
1 Domestic 3 Feedlot 6 Oil field water supply 9 Dewatering 12 Other (Specify below)
2 Irrigation 4 Industrial 7 Lawn and garden only (10) Monitoring well
Was a chemical/bacteriological sample submitted to Department? Yes (No); If yes, mo/day/yr sample was submitted
Water Well Disinfected? Yes (No)

5 TYPE OF BLANK CASING USED: 5 Wrought iron 8 Concrete tile CASING JOINTS: Glued Clamped
1 Steel 3 RMP (SR) 6 Asbestos-Cement 9 Other (specify below) Welded
(2) PVC 4 ABS 7 Fiberglass Threaded FLUSH JOINT
Blank casing diameter 2 in. to 9.80 ft., Dia in. to ft., Dia in. to ft.
Casing height above land surface -0.1 in., weight lbs./ft. Wall thickness or gauge No. SCH 40

TYPE OF SCREEN OR PERFORATION MATERIAL: (7) PVC 10 Asbestos-cement
1 Steel 3 Stainless steel 5 Fiberglass 8 RMP (SR) 11 Other (specify)
2 Brass 4 Galvanized steel 6 Concrete tile 9 ABS 12 None used (open hole)

SCREEN OR PERFORATION OPENINGS ARE: 5 Gauzed wrapped 8 Saw cut 11 None (open hole)
1 Continuous slot (3) Mill slot 6 Wire wrapped 9 Drilled holes
2 Louvered shutter 4 Key punched 7 Torch cut 10 Other (specify)

SCREEN-PERFORATED INTERVALS: From 9.8 ft. to 24.8 ft., From ft. to ft.
From ft. to ft., From ft. to ft.
GRAVEL PACK INTERVALS: From 8.1 ft. to 30.0 ft., From ft. to ft.
From ft. to ft., From ft. to ft.

6 GROUT MATERIAL: 1 Neat cement (2) Cement grout (3) Bentonite (4) Other SAND
Grout Intervals: From 0 ft. to 2.1 ft., From 2.1 ft. to 8.1 ft., From 8.1 ft. to 30.0 ft.
What is the nearest source of possible contamination:
1 Septic tank 4 Lateral lines 7 Pit privy 10 Livestock pens 14 Abandoned water well
2 Sewer lines 5 Cess pool 8 Sewage lagoon (11) Fuel storage 15 Oil well/Gas well
3 Watertight sewer lines 6 Seepage pit 9 Feedyard 12 Fertilizer storage 16 Other (specify below)
13 Insecticide storage
Direction from well? NE How many feet? 400.0

FROM	TO	LITHOLOGIC LOG	FROM	TO	PLUGGING INTERVALS
0	.5	GRASS COVERED CLAY TOPSOIL			
.5	7.0	MED, COARSE TO FINE SILTY SAND			
7.0	12.0	SOFT, FINE SILTY SAND			
12.0	17.0	STIFF FINE SILTY SAND			
17.0	22.0	FINE SILTY SAND TRACE GRAVEL			
22.0	30	MED FINE SILTY SAND			

7 CONTRACTOR'S OR LANDOWNER'S CERTIFICATION: This water well was (1) constructed, (2) reconstructed, or (3) plugged under my jurisdiction and was completed on (mo/day/year) 12-14-94 and this record is true to the best of my knowledge and belief. Kansas Water Well Contractor's License No. 529 This Water Well Record was completed on (mo/day/yr) 12/20/94 under the business name of GEOTECHNOLOGY, INC by (signature)

INSTRUCTIONS: Use typewriter or ball point pen. *PLEASE PRESS FIRMLY* and *PRINT* clearly. Please fill in blanks, underline or circle the correct answers. Send top three copies to Kansas Department of Health and Environment, Bureau of Water, Topeka, Kansas 66620-0001. Telephone: 913-296-5545. Send one to WATER WELL OWNER and retain one for your records.

OFFICE USE ONLY