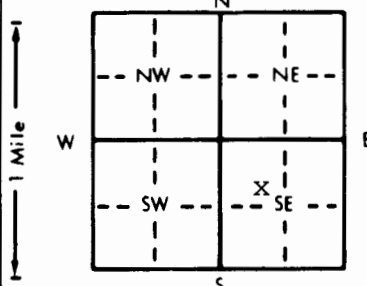


1 LOCATION OF WATER WELL: County: Ellis	Fraction SE 1/4 NW 1/4 SE 1/4	Section Number 11	Township Number T 13 S	Range Number R 19 XEW
---	---	-----------------------------	----------------------------------	--

Distance and direction from nearest town or city street address of well if located within city?
2 1/4 miles north, 4 miles west, 1/4 mile north of Hays, Kansas

2 WATER WELL OWNER: **Ellis County Feeders**
 RR#, St. Address, Box # : **P.O. Box 310**
 City, State, ZIP Code : **Hays, Kansas 67601**
 Board of Agriculture, Division of Water Resources
 Application Number:

3 LOCATE WELL'S LOCATION WITH AN "X" IN SECTION BOX: 	4 DEPTH OF COMPLETED WELL: 50 ft. ELEVATION: Valley Depth(s) Groundwater Encountered 1. 30 ft. 2. _____ ft. 3. _____ ft. WELL'S STATIC WATER LEVEL: 5 ft. below land surface measured on mo/day/yr 6/27/95 Pump test data: Well water was 5 ft. after 1 hours pumping 30 gpm Est. Yield 30 gpm: Well water was _____ ft. after _____ hours pumping _____ gpm Bore Hole Diameter: 13 in. to 50 ft., and _____ in. to _____ ft. WELL WATER TO BE USED AS: 3 5 Public water supply 8 Air conditioning 11 Injection well 1 Domestic 3 Feedlot 6 Oil field water supply 9 Dewatering 12 Other (Specify below) 2 Irrigation 4 Industrial 7 Lawn and garden only 10 Monitoring well _____ Was a chemical/bacteriological sample submitted to Department? Yes _____ No X _____; If yes, mo/day/yr sample was submitted _____ Water Well Disinfected? Yes X No _____
---	--

5 TYPE OF BLANK CASING USED: 2 _____ 5 Wrought iron 8 Concrete tile CASING JOINTS: Glued **X** Clamped _____
 1 Steel 3 RMP (SR) 6 Asbestos-Cement 9 Other (specify below) Welded _____
 2 PVC 4 ABS 7 Fiberglass _____ Threaded _____
 Blank casing diameter **5** in. to **30** ft., Dia _____ in. to _____ ft., Dia _____ in. to _____ ft.
 Casing height above land surface **24** in., weight **2.29** lbs./ft. Wall thickness or gauge No. **26**
 TYPE OF SCREEN OR PERFORATION MATERIAL: 7 _____ 10 Asbestos-cement
 1 Steel 3 Stainless steel 5 Fiberglass 8 RMP (SR) 11 Other (specify) _____
 2 Brass 4 Galvanized steel 6 Concrete tile 9 ABS 12 None used (open hole)
 SCREEN OR PERFORATION OPENINGS ARE: 8 _____ 5 Gauzed wrapped **8** Saw cut 11 None (open hole)
 1 Continuous slot 3 Mill slot 6 Wire wrapped 9 Drilled holes
 2 Louvered shutter 4 Key punched 7 Torch cut 10 Other (specify) _____
 SCREEN-PERFORATED INTERVALS: From **50** ft. to **25** ft., From _____ ft. to _____ ft.
 From _____ ft. to _____ ft., From _____ ft. to _____ ft.
 GRAVEL PACK INTERVALS: From **23** ft. to **50** ft., From _____ ft. to _____ ft.
 From _____ ft. to _____ ft., From _____ ft. to _____ ft.

6 GROUT MATERIAL: 3 1 Neat cement 2 Cement grout **3** Bentonite 4 Other _____
 Grout intervals: From **3** ft. to **23** ft., From _____ ft. to _____ ft., From _____ ft. to _____ ft.
 What is the nearest source of possible contamination: **None**
 1 Septic tank 4 Lateral lines 7 Pit privy 10 Livestock pens 14 Abandoned water well
 2 Sewer lines 5 Cess pool 8 Sewage lagoon 11 Fuel storage 15 Oil well/Gas well
 3 Watertight sewer lines 6 Seepage pit 9 Feedyard 12 Fertilizer storage 16 Other (specify below)
 13 Insecticide storage _____

Direction from well?		LITHOLOGIC LOG		PLUGGING INTERVALS	
FROM	TO	FROM	TO	FROM	TO
0	8				
		Topsoil			
8	20	Gumbo, loose rock			
20	37	Loose rock			
37	50	Shale			

7 CONTRACTOR'S OR LANDOWNER'S CERTIFICATION: This water well was (1) constructed, (2) reconstructed, or (3) plugged under my jurisdiction and was completed on (mo/day/year) 1/30/96 and this record is true to the best of my knowledge and belief. Kansas Water Well Contractor's License No. 199. This Water Well Record was completed on (mo/day/yr) 2/27/96 under the business name of Karst Water Well Drilling & Service, Inc. by (signature) *[Signature]*

OFFICE USE ONLY
T
R
EM
SEC.
1/4
1/4
1/4