


1 LOCATION OF WATER WELL: County: Ellis Fraction: NE 1/4 NE 1/4 NE 1/4 Section Number: 16 Township Number: T 13 S Range Number: R 19 E/W

Distance and direction from nearest town or city street address of well if located within city?  
1 mi. North 4 mi West 1 mi North of Hays Ks.

2 WATER WELL OWNER: James R. Hoyt  
 RR#, St. Address, Box #: 1691 Yocum Ave. Board of Agriculture, Division of Water Resources  
 City, State, ZIP Code: Hays Ks. 67637 Application Number:

3 LOCATE WELL'S LOCATION WITH AN "X" IN SECTION BOX:

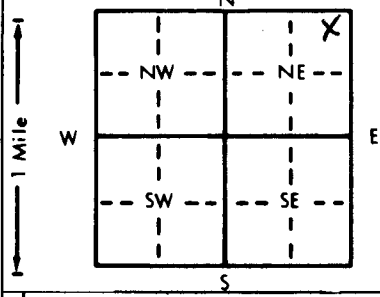

4 DEPTH OF COMPLETED WELL: 80 ft. ELEVATION:  
 Depth(s) Groundwater Encountered 1. 69 ft. 2. ft. 3. ft.  
 WELL'S STATIC WATER LEVEL: 53 ft. below land surface measured on 8-22-92  
 Pump test data: Well water was 28 ft. after 1 hours pumping 8 gpm  
 Est. Yield 20 gpm: Well water was ft. after hours pumping gpm  
 Bore Hole Diameter: 10 in. to ft., and in. to ft.  
 WELL WATER TO BE USED AS:  
 Domestic 3 Feedlot 6 Oil field water supply 9 Dewatering 12 Other (Specify below)  
 Irrigation 4 Industrial 7 Lawn and garden only 10 Monitoring well  
 Was a chemical/bacteriological sample submitted to Department? Yes No  If yes, mo/day/yr sample was submitted  
 Water Well Disinfected?  Yes No

5 TYPE OF BLANK CASING USED:  
 1 Steel 3 RMP (SR) 5 Wrought iron 8 Concrete tile CASING JOINTS:  Glued  Clamped  
 PVC 4 ABS 6 Asbestos-Cement 9 Other (specify below)  Welded  
 7 Fiberglass Threaded  
 Blank casing diameter: 5 in. to ft., Dia. in. to ft., Dia. in. to ft.  
 Casing height above land surface: 20 in., weight lbs./ft. Wall thickness or gauge No. SDR-20

TYPE OF SCREEN OR PERFORATION MATERIAL:  
 1 Steel 3 Stainless steel 5 Fiberglass 8 RMP (SR) 10 Asbestos-cement  
 2 Brass 4 Galvanized steel 6 Concrete tile 9 ABS 11 Other (specify)  
 12 None used (open hole)

SCREEN OR PERFORATION OPENINGS ARE:  
 1 Continuous slot  3 Mill slot 5 Gauzed wrapped 8 Saw cut 11 None (open hole)  
 2 Louvered shutter 4 Key punched 6 Wire wrapped 9 Drilled holes  
 7 Torch cut 10 Other (specify)

SCREEN-PERFORATED INTERVALS: From 61 ft. to 80 ft., From ft. to ft.  
 From ft. to ft., From ft. to ft.  
 GRAVEL-PACK INTERVALS: From 45 ft. to 80 ft., From ft. to ft.  
 From ft. to ft., From ft. to ft.

6 GROUT MATERIAL: 1 Neat cement  2 Cement grout 3 Bentonite 4 Other  
 Grout Intervals: From 5 ft. to 25 ft., From ft. to ft., From ft. to ft.

What is the nearest source of possible contamination:  
 1 Septic tank 4 Lateral lines 7 Pit privy  10 Livestock pens 14 Abandoned water well  
 2 Sewer lines 5 Cess pool 8 Sewage lagoon 11 Fuel storage 15 Oil well/Gas well  
 3 Watertight sewer lines 6 Seepage pit 9 Feedyard 12 Fertilizer storage 16 Other (specify below)  
 13 Insecticide storage  
 Direction from well? WEST How many feet? 100-150

FROM	TO	LITHOLOGIC LOG	FROM	TO	PLUGGING INTERVALS
0	5	Top soil			
5	69	Brown clay			
69	75	med to fine grey sand			
75	78	med to coarse Red & grey sand			
78	80	shale			

7 CONTRACTOR'S OR LANDOWNER'S CERTIFICATION: This water well was  constructed,  reconstructed, or  plugged under my jurisdiction and was completed on (mo/day/year) 8-22-92 and this record is true to the best of my knowledge and belief. Kansas Water Well Contractor's License No. 276 This Water Well Record was completed on (mo/day/yr) 8-22-92 under the business name of hysa Water Well Drilling by (signature) John Dyer

INSTRUCTIONS: Use typewriter or ball point pen. PLEASE PRESS FIRMLY and PRINT clearly. Please fill in blanks, underline or circle the correct answers. Send top three copies to Kansas Department of Health and Environment, Bureau of Water, Topeka, Kansas 66620-0001. Telephone: 913-296-5545. Send one to WATER WELL OWNER and retain one for your records.