


1 LOCATION OF WATER WELL: County: Ellis Fraction: NE 1/4 SW 1/4 SW 1/4 Section Number: 21 Township Number: T 13 S Range Number: R 19 E/W

Distance and direction from nearest town or city street address, of well if located within city?
Take I-70 west to Yosemite Exit (1 mile) go 1 mile South and 1/8 mile West South side

2 WATER WELL OWNER: Steve Selagels
 RR#, St. Address, Box #: Rt 2
 City, State, ZIP Code: Hays, Ks
 Board of Agriculture, Division of Water Resources
 Application Number:

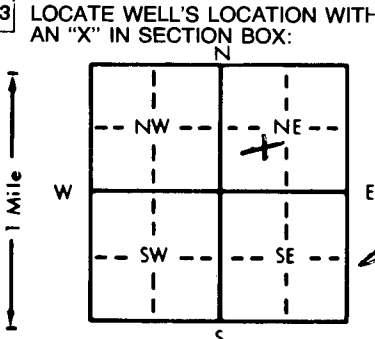

4 DEPTH OF COMPLETED WELL: 48ft ft. ELEVATION: ft.
 Depth(s) Groundwater Encountered 1. 31ft ft. 2. ft. 3. ft.
 WELL'S STATIC WATER LEVEL: 26 ft. below land surface measured on mo/day/yr 8/5/85
 Pump test data: Well water was ft. after hours pumping gpm
 Est. Yield 20+ gpm: Well water was ft. after hours pumping gpm
 Bore Hole Diameter: 10 1/4 in. to 48ft ft., and in. to ft.
 WELL WATER TO BE USED AS:
 1 Domestic 3 Feedlot 6 Oil field water supply 9 Dewatering 12 Other (Specify below)
 2 Irrigation 4 Industrial 7 Lawn and garden only 10 Observation well
 Was a chemical/bacteriological sample submitted to Department? Yes.....No. X.....; If yes, mo/day/yr sample was submitted
 Water Well Disinfected? Yes X (No)

5 TYPE OF BLANK CASING USED:
 1 Steel 3 RMP (SR) 5 Wrought iron 8 Concrete tile CASING JOINTS: Glued X Clamped
 2 PVC 4 ABS 6 Asbestos-Cement 9 Other (specify below) Welded
 Blank casing diameter: 5.56 in. to 28ft ft., Dia in. to ft., Dia in. to ft.
 Casing height above land surface: 18 inches in., weight lbs./ft. Wall thickness or gauge No. SDR-26
 TYPE OF SCREEN OR PERFORATION MATERIAL:
 1 Steel 3 Stainless steel 5 Fiberglass 8 RMP (SR) 11 Other (specify)
 2 Brass 4 Galvanized steel 6 Concrete tile 9 ABS 12 None used (open hole)
 SCREEN OR PERFORATION OPENINGS ARE:
 1 Continuous slot 3 Mill slot 5 Gauzed wrapped Saw cut 11 None (open hole)
 2 Louvered shutter 4 Key punched 6 Wire wrapped 9 Drilled holes
 7 Torch cut 10 Other (specify)
 SCREEN-PERFORATED INTERVALS: From 48 ft. to 28 ft., From ft. to ft.
 From ft. to ft., From ft. to ft.
 GRAVEL PACK INTERVALS: From 48 ft. to 10 ft., From ft. to ft.
 From ft. to ft., From ft. to ft.

6 GROUT MATERIAL: 1 Neat cement 2 Cement grout 3 Bentonite 4 Other
 Grout Intervals: From 10 ft. to 0 ft., From ft. to ft., From ft. to ft.
 What is the nearest source of possible contamination:
Septic tank 4 Lateral lines 7 Pit privy 10 Livestock pens 14 Abandoned water well
 2 Sewer lines 5 Cess pool 8 Sewage lagoon 11 Fuel storage 15 Oil well/Gas well
 3 Watertight sewer lines 6 Seepage pit 9 Feedyard 12 Fertilizer storage 16 Other (specify below)
 13 Insecticide storage
 Direction from well? West
 How many feet? 250ft

FROM	TO	LITHOLOGIC LOG	FROM	TO	LITHOLOGIC LOG
0	3	Top soil			
3	17	Hard yellow clay			
17	46	medium to coarse sand and gravel			
46	48	Blue shale			

7 CONTRACTOR'S OR LANDOWNER'S CERTIFICATION: This water well was (1) constructed (2) reconstructed, or (3) plugged under my jurisdiction and was completed on (mo/day/year) 8/5/85 and this record is true to the best of my knowledge and belief. Kansas Water Well Contractor's License No. 455 This Water Well Record was completed on (mo/day/yr) 8/17/85 under the business name of Travis Pump & Supply by (signature) James Bieker
 INSTRUCTIONS: Use typewriter or ball point pen, PLEASE PRESS FIRMLY and PRINT clearly. Please fill in blanks, underline or circle the correct answers. Send top three copies to Kansas Department of Health and Environment, Division of Environment, Environmental Geology Section, Topeka, KS 66620. Send one to WATER WELL OWNER and retain one for your records.