


1 LOCATION OF WATER WELL: Fraction SE 1/4 SE 1/4 NE 1/4 Section Number 22 Township Number T 13 S Range Number R 19 EW  
 County: ELLIS

Distance and direction from nearest town or city street address of well if located within city?  
3 miles West of Hays Ks on old Hwy 40 1/2 north

2 WATER WELL OWNER: JIM CLARK  
 RR#, St. Address, Box #: RT 1 Board of Agriculture, Division of Water Resources  
 City, State, ZIP Code: Hays Ks 67601 Application Number:

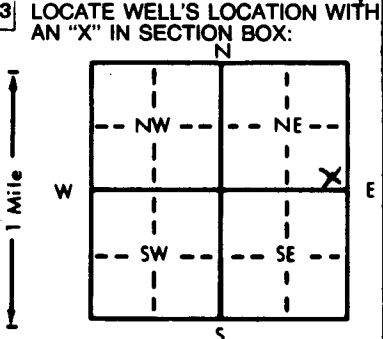

4 DEPTH OF COMPLETED WELL: 35 ft. ELEVATION: .....  
 Depth(s) Groundwater Encountered 1. 25 ft. 2. .... ft. 3. .... ft.  
 WELL'S STATIC WATER LEVEL 26 ft. below land surface measured on mo/day/yr 5/12/87  
 Pump test data: Well water was 3 ft. after 1 hours pumping 10 gpm  
 Est. Yield 10 gpm: Well water was ..... ft. after ..... hours pumping ..... gpm  
 Bore Hole Diameter 10 in. to ..... ft., and ..... in. to ..... ft.  
 WELL WATER TO BE USED AS:  
 1 Domestic     3 Feedlot     6 Oil field water supply     9 Dewatering     12 Other (Specify below)  
 2 Irrigation     4 Industrial     7 Lawn and garden only     10 Observation well  
 Was a chemical/bacteriological sample submitted to Department? Yes.....No.....; If yes, mo/day/yr sample was submitted  
 Water Well Disinfected  Yes     No

5 TYPE OF BLANK CASING USED:  
 1 Steel    3 RMP (SR)    5 Wrought iron    8 Concrete tile    CASING JOINTS:  Glued     Clamped  
 2 PVC    4 ABS    6 Asbestos-Cement    9 Other (specify below)     Welded  
 Blank casing diameter 5 in. to ..... ft., Dia ..... in. to ..... ft., Dia ..... in. to ..... ft.  
 Casing height above land surface 20 in., weight ..... lbs./ft. Wall thickness or gauge No. ....  
 TYPE OF SCREEN OR PERFORATION MATERIAL:  7 PVC    10 Asbestos-cement  
 1 Steel    3 Stainless steel    5 Fiberglass    8 RMP (SR)    11 Other (specify) .....  
 2 Brass    4 Galvanized steel    6 Concrete tile    9 ABS    12 None used (open hole)  
 SCREEN OR PERFORATION OPENINGS ARE:  
 1 Continuous slot    3 Mill slot    5 Gauzed wrapped     8 Saw cut    11 None (open hole)  
 2 Louvered shutter    4 Key punched    6 Wire wrapped    9 Drilled holes  
 7 Torch cut    10 Other (specify) .....  
 SCREEN-PERFORATED INTERVALS: From 15 ft. to 35 ft., From ..... ft. to ..... ft.  
 From ..... ft. to ..... ft., From ..... ft. to ..... ft.  
 GRAVEL PACK INTERVALS: From 0.7 ft. to 35 ft., From ..... ft. to ..... ft.  
 From ..... ft. to ..... ft., From ..... ft. to ..... ft.

6 GROUT MATERIAL: 1 Neat cement     2 Cement grout    3 Bentonite    4 Other .....  
 Grout Intervals: From 4 ft. to 24 ft., From ..... ft. to ..... ft., From ..... ft. to ..... ft.  
 What is the nearest source of possible contamination:  
 1 Septic tank    4 Lateral lines    7 Pit privy    10 Livestock pens    14 Abandoned water well  
 2 Sewer lines    5 Cess pool    8 Sewage lagoon    11 Fuel storage    15 Oil well/Gas well  
 3 Watertight sewer lines    6 Seepage pit    9 Feedyard    12 Fertilizer storage    16 Other (specify below)  
 13 Insecticide storage .....  
 Direction from well? North How many feet? 80

| FROM | TO | LITHOLOGIC LOG              | FROM | TO | LITHOLOGIC LOG |
|------|----|-----------------------------|------|----|----------------|
| 0    | 10 | top soil                    |      |    |                |
| 10   | 25 | brown clay                  |      |    |                |
| 25   | 33 | grey & red med to fine sand |      |    |                |
| 33   | 35 | shale                       |      |    |                |

7 CONTRACTOR'S OR LANDOWNER'S CERTIFICATION: This water well was  (1) constructed,  (2) reconstructed, or  (3) plugged under my jurisdiction and was completed on (mo/day/year) 5/12/87 and this record is true to the best of my knowledge and belief. Kansas Water Well Contractor's License No. 276 This Water Well Record was completed on (mo/day/yr) 5/12/87 under the business name of HUSA WATER WELL DRILLING by (signature) John...

INSTRUCTIONS: Use typewriter or ball point pen. PLEASE PRESS FIRMLY and PRINT clearly. Please fill in blanks, underline or circle the correct answers. Send top three copies to Kansas Department of Health and Environment, Office of Oil Field and Environmental Geology, Regulation and Permitting Section, Topeka, Kansas 66620-7500, Telephone: 913-862-9360. Send one to WATER WELL OWNER and retain one for your records.