

WATER WELL RECORD Form WWC-5 KSA 82a-1212 ID No.

1] LOCATION OF WATER WELL: County: Ellis	Fraction SE ¼ NE ¼ NE ¼	Section Number 9	Township Number T 13 S	Range Number R 19w E/W
--	-----------------------------------	----------------------------	----------------------------------	----------------------------------

Distance and direction from nearest town or city street address of well if located within city?

1 1/2N of Yocemento, KS


2] WATER WELL OWNER: **Chuck and Sandy Zalina**

RR#, St. Address, Box # : **1731 Yocemento Ave.**

Board of Agriculture, Division of Water Resources
Application Number:

City, State, ZIP Code : **Hay, Ks. 67601**

3] LOCATE WELL'S LOCATION WITH AN "X" IN SECTION BOX: 4] DEPTH OF COMPLETED WELL... **56** ... ft. ELEVATION: **unknown**

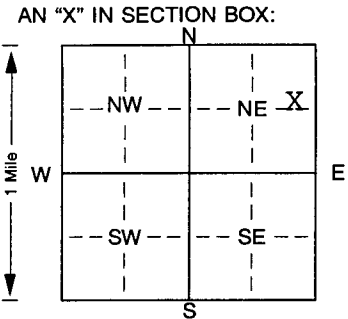

Depth(s) Groundwater Encountered 1... **44** ... ft. 2. ... ft. 3. ... ft.
WELL'S STATIC WATER LEVEL... **44** ... ft. below land surface measured on mo/day/yr ... **07/03/03** ...
Pump test data: Well water was ... ft. after ... hours pumping ... gpm
Est. Yield ... **8** ... gpm: Well water was ... ft. after ... hours pumping ... gpm
Bore Hole Diameter... ~~38~~ **8** . in. to ... **56** ... ft., and ... in. to ... ft.
WELL WATER TO BE USED AS: 5 Public water supply 8 Air conditioning 11 Injection well
1 Domestic 3 Feedlot 6 Oil field water supply 9 Dewatering 12 Other (Specify below)
2 Irrigation 4 Industrial 7 Domestic (lawn & garden) 10 Monitoring well ...
Was a chemical/bacteriological sample submitted to Department? Yes. ... No. ... ; If yes, mo/day/yr sample was submitted
Water Well Disinfected? Yes No

5] TYPE OF BLANK CASING USED: 5 Wrought iron 8 Concrete tile CASING JOINTS: Glued. ... Clamped. ...

1 Steel 3 RMP (SR) 6 Asbestos-Cement 9 Other (specify below) Welded ...
2 PVC 4 ABS 7 Fiberglass ... Threaded. ...
Blank casing diameter ... **5** ... in. to ... **36** ... ft., Dia ... in. to ... ft., Dia ... in. to ... ft.
Casing height above land surface ... **12** ... in., weight ... **2.8** ... lbs./ft. Wall thickness or gauge No. ... **Sch. 40** ...

TYPE OF SCREEN OR PERFORATION MATERIAL: 7 PVC 10 Asbestos-cement
1 Steel 3 Stainless steel 5 Fiberglass 8 RMP (SR) 11 Other (specify) ...
2 Brass 4 Galvanized steel 6 Concrete tile 9 ABS 12 None used (open hole)

SCREEN OR PERFORATION OPENINGS ARE: 5 Gauzed wrapped 8 Saw cut 11 None (open hole)
1 Continuous slot 3 Mill slot 6 Wire wrapped 9 Drilled holes
2 Louvered shutter 4 Key punched 7 Torch cut 10 Other (specify) ... ft.

SCREEN-PERFORATED INTERVALS: From ... **36** ... ft. to ... **56** ... ft., From ... ft. to ... ft.
From ... ft. to ... ft., From ... ft. to ... ft.
GRAVEL PACK INTERVALS: From ... **21** ... ft. to ... **30** ... ft., From ... **35** ... ft. to ... **56** ... ft.
From ... ft. to ... ft., From ... ft. to ... ft.

6] GROUT MATERIAL: 1 Neat cement 2 Cement grout 3 Bentonite 4 Other ...
Grout Intervals: From ... **0** ... ft. to ... **21** ... ft., From ... **30** ... ft. to ... **35** ... ft., From ... ft. to ... ft.

What is the nearest source of possible contamination:
1 Septic tank 4 Lateral lines 7 Pit privy 10 Livestock pens 14 Abandoned water well
2 Sewer lines 5 Cess pool 8 Sewage lagoon 11 Fuel storage 15 Oil well/Gas well
3 Watertight sewer lines 6 Seepage pit 9 Feedyard 12 Fertilizer storage 16 Other (specify below)
Direction from well? **Northwest** 13 Insecticide storage **house**
How many feet? **240**

FROM	TO	LITHOLOGIC LOG	FROM	TO	PLUGGING INTERVALS
0	3	top soil			
3	21	clay			
21	27	sand and gravel			
27	35	clay			
35	50	sand and gravel			
50	56	shale			

7] CONTRACTOR'S OR LANDOWNER'S CERTIFICATION: This water well was (1) constructed, (2) reconstructed, or (3) plugged under my jurisdiction and was completed on (mo/day/year) ... **07/03/03** ... and this record is true to the best of my knowledge and belief. Kansas Water Well Contractor's Licence No. ... **186** ... This Water Well Record was completed on (mo/day/yr) ... **07/07/03** ... under the business name of **Kelly's Water Well Service, Inc.** by (signature) *Kathryn L Good*