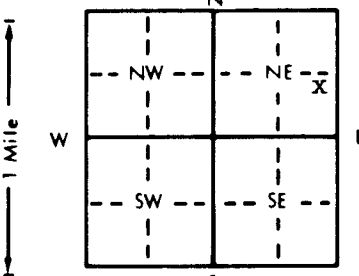


1 LOCATION OF WATER WELL: Fraction NE 1/4 SE 1/4 NE 1/4 Section Number 35 Township Number T 13 S Range Number R 2 EW

Distance and direction from nearest town or city street address of well if located within city?  
 NORTHEAST CORNER NEW CAMBRIA, KS

2 WATER WELL OWNER: CITY OF NEW CAMBRIA  
 RR#, St. Address, Box # : Board of Agriculture, Division of Water Resources  
 City, State, ZIP Code : NEW CAMBRIA, KS. 67470 Application Number:

3 LOCATE WELL'S LOCATION WITH AN "X" IN SECTION BOX:  

 4 DEPTH OF COMPLETED WELL: 55.2 ft. ELEVATION:  
 Depth(s) Groundwater Encountered 1. 13.7 ft. 2. ft. 3. ft.  
 WELL'S STATIC WATER LEVEL 13.7 ft. below land surface measured on mo/day/yr 5-30-96  
 Pump test data: Well water was 15.4 ft. after 1 hours pumping 20 gpm  
 Est. Yield 60 gpm: Well water was ft. after hours pumping gpm  
 Bore Hole Diameter 9 in. to 56 ft., and in. to ft.  
 WELL WATER TO BE USED AS: 5 Public water supply 8 Air conditioning 11 Injection well  
 1 Domestic 3 Feedlot 6 Oil field water supply 9 Dewatering 12 Other (Specify below)  
 2 Irrigation 4 Industrial 7 Lawn and garden only 10 Monitoring well  
 Was a chemical/bacteriological sample submitted to Department? Yes No X If yes, mo/day/yr sample was submitted  
 Water Well Disinfected? Yes X No

5 TYPE OF BLANK CASING USED: 5 Wrought iron 8 Concrete tile CASING JOINTS: Glued X Clamped  
 1 Steel 3 RMP (SR) 6 Asbestos-Cement 9 Other (specify below) Welded  
 2 PVC 4 ABS 7 Fiberglass Threaded  
 Blank casing diameter 5 in. to 45 ft., Dia in. to ft., Dia in. to ft.  
 Casing height above land surface 22 in., weight 160 lbs./ft. Wall thickness or gauge No. SDR 26  
 TYPE OF SCREEN OR PERFORATION MATERIAL: 7 PVC 10 Asbestos-cement  
 1 Steel 3 Stainless steel 5 Fiberglass 8 RMP (SR) 11 Other (specify)  
 2 Brass 4 Galvanized steel 6 Concrete tile 9 ABS 12 None used (open hole)  
 SCREEN OR PERFORATION OPENINGS ARE: 5 Gauzed wrapped 8 Saw cut 11 None (open hole)  
 1 Continuous slot 3 Mill slot .035 6 Wire wrapped 9 Drilled holes  
 2 Louvered shutter 4 Key punched 7 Torch cut 10 Other (specify)  
 SCREEN-PERFORATED INTERVALS: From 45 ft. to 55 ft., From ft. to ft.  
 From ft. to ft., From ft. to ft.  
 GRAVEL PACK INTERVALS: From 35 ft. to 55 ft., From ft. to ft.  
 From ft. to ft., From ft. to ft.

6 GROUT MATERIAL: 1 Neat cement 2 Cement grout 3 Bentonite 4 Other  
 Grout intervals: From 0 ft. to 21 ft., From ft. to ft., From ft. to ft.  
 What is the nearest source of possible contamination:  
 1 Septic tank 4 Lateral lines 7 Pit privy 10 Livestock pens 14 Abandoned water well  
 2 Sewer lines 5 Cess pool 8 Sewage lagoon 11 Fuel storage 15 Oil well/Gas well  
 3 Watertight sewer lines 6 Seepage pit 9 Feedyard 12 Fertilizer storage 16 Other (specify below)  
 NONE APPARENT  
 Direction from well? How many feet?

FROM	TO	LITHOLOGIC LOG	FROM	TO	PLUGGING INTERVALS
0	2	FILL DIRT			
2	32	CLAY TAN SILTY			
32	44	CLAY GRAY SOFT			
44	55	CLAY GRAY WITH COARSE SAND LAYERS			

7 CONTRACTOR'S OR LANDOWNER'S CERTIFICATION: This water well was (1) constructed, (2) reconstructed, or (3) plugged under my jurisdiction and was completed on (mo/day/year) 5-30-96 and this record is true to the best of my knowledge and belief. Kansas Water Well Contractor's License No. 388 This Water Well Record was completed on (mo/day/yr) 5-30-96 under the business name of PESTINGER PUMP SERVICE by (signature) [Signature]

INSTRUCTIONS: Use typewriter or ball point pen. PLEASE PRESS FIRMLY and PRINT clearly. Please fill in blanks, underline or circle the correct answers. Send top three copies to Kansas Department of Health and Environment, Bureau of Water, Topeka, Kansas 66620-0001. Telephone: 913-296-5545. Send one to WATER WELL OWNER and retain one for your records.

OFFICE USE ONLY  
T  
R  
EW  
SEC.