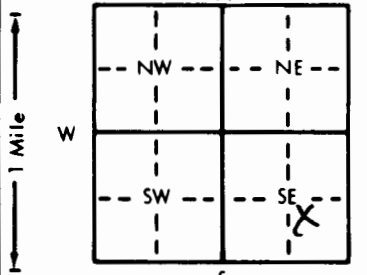


1 LOCATION OF WATER WELL: County: SALINE Fraction: NW 1/4 SE 1/4 SE 1/4 Section Number: 35 Township Number: T 13 S Range Number: R 3 X EW

Distance and direction from nearest town or city street address of well if located within city? 1001 N 10th

2 WATER WELL OWNER: Don Schaeffer
 RR#, St. Address, Box #: 1001 N 10th
 City, State, ZIP Code: Salina, Kansas 67401 Board of Agriculture, Division of Water Resources
 Application Number: 1215

3 LOCATE WELL'S LOCATION WITH AN "X" IN SECTION BOX:  4 DEPTH OF COMPLETED WELL: 45 ft. ELEVATION: 1215
 Depth(s) Groundwater Encountered 1. 19 ft. 2. 19 ft. 3. 19 ft.
 WELL'S STATIC WATER LEVEL 19 ft. below land surface measured on mo/day/yr 4-27-97
 Pump test data: Well water was 22 ft. after 1 1/2 hours pumping 15 gpm
 Est. Yield 25 gpm; Well water was 22 ft. after 1 1/2 hours pumping 15 gpm
 Bore Hole Diameter: 3 1/2 in. to 34 ft., and 5 1/2 in. to 45 ft.
 WELL WATER TO BE USED AS:
 5 Public water supply 8 Air conditioning 11 Injection well
 1 Domestic 3 Feedlot 6 Oil field water supply 9 Dewatering 12 Other (Specify below)
 2 Irrigation 4 Industrial 7 Lawn and garden only 10 Monitoring well
 Was a chemical/bacteriological sample submitted to Department? Yes No; If yes, mo/day/yr sample was submitted
 Water Well Disinfected? Yes X No

5 TYPE OF BLANK CASING USED:
 1 Steel 3 RMP (SR) 5 Wrought iron 8 Concrete tile CASING JOINTS: Glued X Clamped
2 PVC 4 ABS 6 Asbestos-Cement 9 Other (specify below) Welded
 7 Fiberglass Threaded
 Blank casing diameter 5 in. to 35 ft., Dia. in. to in. Dia. in. to in. ft.
 Casing height above land surface 16 in., weight 160 LB lbs./ft. Wall thickness or gauge No. SDR 26
 TYPE OF SCREEN OR PERFORATION MATERIAL:
 1 Steel 3 Stainless steel 5 Fiberglass 8 RMP (SR) 10 Asbestos-cement
 2 Brass 4 Galvanized steel 6 Concrete tile 9 ABS 11 Other (specify)
 12 None used (open hole)
 SCREEN OR PERFORATION OPENINGS ARE:
 1 Continuous slot 3 Mill slot 5 Gauzed wrapped 8 Saw cut 11 None (open hole)
 2 Louvered shutter 4 Key punched 6 Wire wrapped 9 Drilled holes
 7 Torch cut 10 Other (specify)
 SCREEN-PERFORATED INTERVALS: From 35 ft. to 45 ft., From ft. to ft. ft.
 From ft. to ft., From ft. to ft. ft.
 GRAVEL PACK INTERVALS: From 21 ft. to 45 ft., From ft. to ft. ft.
 From ft. to ft., From ft. to ft. ft.

6 GROUT MATERIAL: 1 Heat cement 2 Cement grout 3 Bentonite 4 Other
 Grout intervals: From 0 ft. to 21 ft., From ft. to ft. ft., From ft. to ft. ft.
 What is the nearest source of possible contamination:
 1 Septic tank 4 Lateral lines 7 Pit privy 10 Livestock pens 14 Abandoned water well
 2 Sewer lines 5 Cess pool 8 Sewage lagoon 11 Fuel storage 15 Oil well/Gas well
3 Watertight sewer lines 6 Seepage pit 9 Feedyard 12 Fertilizer storage 16 Other (specify below)
 13 Insecticide storage
 Direction from well? South How many feet? 25

FROM	TO	LITHOLOGIC LOG	FROM	TO	PLUGGING INTERVALS
0'	2'	TOP soil & fill dirt			
2'	7'	Light Brown Clay & FINE SAND mixed			
7'	33'	Brown Clay			
33'	34'	Grey Clay			
34'	45'	Medium to fine SAND			

7 CONTRACTOR'S OR LANDOWNER'S CERTIFICATION: This water well was (1) constructed, (2) reconstructed, or (3) plugged under my jurisdiction and was completed on (mo/day/year) 4-27-97 and this record is true to the best of my knowledge and belief. Kansas Water Well Contractor's License No. 523 This Water Well Record was completed on (mo/day/yr) 4-27-97 under the business name of M+D Well Service by (signature) Matthew Loukup

OFFICE USE ONLY
T
R
EM
SEC