


1 LOCATION OF WATER WELL: Fraction 1/4 NW 1/4 SW 1/4 NW 1/4 Section Number 31 Township Number T 13 S Range Number 2 [ ] E [X] W

Street/Rural Address of Well Location; if unknown, distance & direction from nearest town or intersection: If at owner's address, check here [ ] 2250 N Ohio, Salina, KS

Global Positioning Systems (GPS) information: Latitude: NA (in decimal degrees) Longitude: NA (in decimal degrees) Elevation: NA Horizontal Datum [ ] WGS84, [ ] NAD83, [ ] NAD27 Collection Method:

2 WATER WELL OWNER: Flying J Incorporated RR#, St. Address, Box #: 333 W. Center City, State ZIP Code: North Salt Lake City, UT 84054

[ ] GPS unit (Make/model: \_\_\_\_\_) [ ] Digital Map/Photo, [ ] Topographic Map, [ ] Land Survey Est. Accuracy: [ ] <3 m, [ ] 3-5 m, [ ] 5-15 m, [ ] >15 m

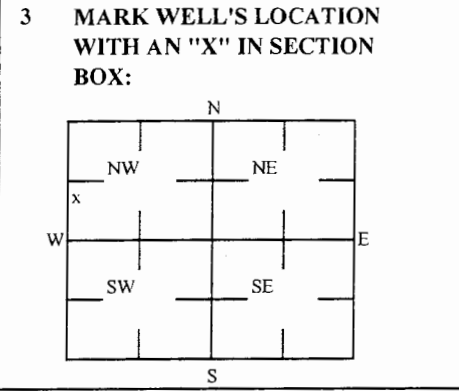

4 DEPTH OF WELL NA ft. MW7 WELL'S STATIC WATER LEVEL \_\_\_\_\_ ft WELL WAS USED AS: [ ] Domestic [ ] Public Water Supply [ ] Dewatering [ ] Irrigation [ ] Oil Field Water Supply [X] Monitoring [ ] Feedlot [ ] Domestic (Lawn & Garden) [ ] Injection Well [ ] Industrial [ ] Air Conditioning [ ] Other \_\_\_\_\_ Was a chemical/bacteriological sample submitted to Department? Yes [ ] No [X]

5 TYPE OF BLANK CASING USED: [ ] Steel [ ] RMP (SR) [ ] Wrought [ ] Fiberglass [ ] Other (Specific below) [X] PVC [ ] ABS [ ] Asbestos-Cement [ ] Concrete Tile Blank casing diameter \_\_\_\_\_ in. Was casing pulled? Yes [ ] No [X] If yes, how much \_\_\_\_\_ Casing height above or below land surface NA in.

6 GROUT PLUG MATERIAL: [ ] Neat cement [ ] Cement grout [X] Bentonite [X] Other Asphalt: 0-0.7' Grout Plug Intervals: From \_\_\_\_\_ ft to \_\_\_\_\_ ft, From \_\_\_\_\_ ft to \_\_\_\_\_ ft, From \_\_\_\_\_ ft to \_\_\_\_\_ ft. What is the nearest source of possible contamination: [ ] Septic tank [ ] Seepage pit [ ] Fuel storage [ ] Other (specify below) [ ] Sewer lines [ ] Pit privy [ ] Fertilizer storage [ ] Watertight sewer lines [ ] Sewage lagoon [ ] Insecticide storage [ ] Lateral lines [ ] Feed yard [ ] Abandoned water well [ ] Cess pool [ ] Livestock pens [ ] Oil well/Gas well Direction from well? \_\_\_\_\_ How many feet? \_\_\_\_\_

Table with columns: FROM, TO, PLUGGING MATERIALS. Row 1: FROM 0, TO 0.7, PLUGGING MATERIALS Asphalt. Note: only the vault was present the well was previously partially plugged. KDHE ID: Flying J Travel Plaza: U5-085-13455

7 CONTRACTOR'S OR LANDOWNER'S CERTIFICATION: This water well was plugged under my jurisdiction and was completed on (mo/day/year) 12/26-28/17 and this record is true to the best of my knowledge and belief. Kansas Water Contractor's License No. 757. This Water Well Record was completed on (mo/day/year) 1/1/2018 under the business name of Larsen & Associates, Inc. By (signature) \_\_\_\_\_