


1 LOCATION OF WATER WELL: County: Saline Fraction 1/4 NW 1/4 SW 1/4 NW 1/4 Section Number 31 Township Number T 13 S Range Number 2 E X W

Street/Rural Address of Well Location; if unknown, distance & direction from nearest town or intersection: If at owner's address, check here 2250 N Ohio, Salina. KS

Global Positioning Systems (GPS) information: Latitude: NA Longitude: NA Elevation: NA Horizontal Datum WGS84 NAD83 NAD27 Collection Method: Est. Accuracy: <3 m 3-5 m 5-15 m >15 m

2 WATER WELL OWNER: Flying J Incorporated RR#, St. Address, Box #: 333 W. Center City, State ZIP Code: North Salt Lake City, UT 84054

GPS unit (Make/model): Digital Map/Photo, Topographic Map, Land Survey

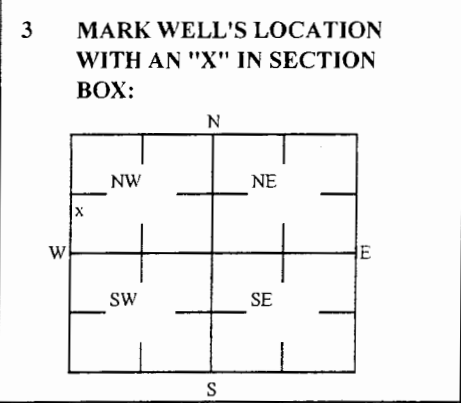

4 DEPTH OF WELL 31.12 ft. MW8 WELL'S STATIC WATER LEVEL ft. WELL WAS USED AS: Domestic, Irrigation, Feedlot, Industrial, Public Water Supply, Oil Field Water Supply, Domestic (Lawn & Garden), Air Conditioning, Dewatering, Monitoring, Injection Well, Other. Was a chemical/bacteriological sample submitted to Department? Yes No X

5 TYPE OF BLANK CASING USED: Steel, PVC, RMP (SR), ABS, Wrought, Asbestos-Cement, Fiberglass, Concrete Tile, Other (Specific below). Blank casing diameter 2 in. Was casing pulled? Yes No X If yes, how much 3' Casing height above or below land surface NA in.

6 GROUT PLUG MATERIAL: Neat cement, Cement grout, Bentonite, Other Asphalt: 0-0.7'; Soil: 0.7-3'. Grout Plug Intervals: From 3 ft to 31.12 ft. What is the nearest source of possible contamination: Septic tank, Sewer lines, Watertight sewer lines, Lateral lines, Cess pool, Seepage pit, Pit privy, Sewage lagoon, Feed yard, Livestock pens, Fuel storage, Fertilizer storage, Insecticide storage, Abandoned water well, Oil well/Gas well, Other (specify below). Direction from well? How many feet?

Table with columns: FROM, TO, PLUGGING MATERIALS. Rows: 0-0.7 Asphalt, 0.7-3 Soil, 3-31.12 Bentonite. Includes KDHE ID: Flying J Travel Plaza: U5-085-13455

7 CONTRACTOR'S OR LANDOWNER'S CERTIFICATION: This water well was plugged under my jurisdiction and was completed on (mo/day/year) 12/26-28/17 and this record is true to the best of my knowledge and belief. Kansas Water Contractor's License No. 757. This Water Well Record was completed on (mo/day/year) 1/9/2018 under the business name of Larsen & Associates, Inc. By (signature)

Send one white copy to Kansas Department of Health & Environment, Geology Section, 1000 SW Jackson Street, Ste. 420, Topeka, KS 66612-1367. Send one copy to WATER WELL OWNER and retain one for your records. Visit us at http://www.kdheks.gov/waterwell/index.html Telephone 785-296-5524.