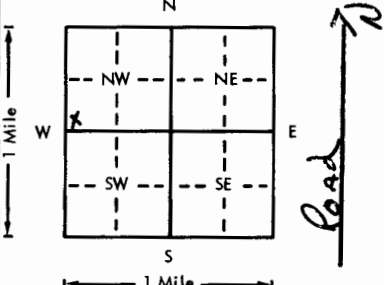


USE TYPEWRITER OR BALL
POINT PEN-PRESS FIRMLY,
PRINT CLEARLY.

WATER WELL RECORD
KSA 82a-1201-1215

Kansas Department of Health and
Environment-Division of Environment
(Water well Contractors)
Topeka, Kansas 66620

1. Location of well:		County SALINE	Fraction SW 1/4 SW 1/4 NW 1/4	Section number 2	Township number T 13 S R 2 E	Range number W
2. Distance and direction from nearest town or city: 5 MI. N. NEW CAMBRIA, KS.			3. Owner of well: NEWTON JORG ESTATE R.R. or street: NEW CAMBRIA, KS. City, state, zip code:			
4. Locate with "X" in section below:		Sketch map:		6. Bore hole dia. 8 in. Completion date Well depth 73 ft. 10-12-78		
				7. Cable tool <input type="checkbox"/> Rotary <input type="checkbox"/> Driven <input type="checkbox"/> Dug <input type="checkbox"/> Hollow rod <input type="checkbox"/> Jetted <input checked="" type="checkbox"/> Bored <input type="checkbox"/> Reverse rotary		
5. Type and color of material		From		To		8. Use: <input checked="" type="checkbox"/> Domestic <input type="checkbox"/> Public supply <input type="checkbox"/> Industry <input type="checkbox"/> Irrigation <input type="checkbox"/> Air conditioning <input type="checkbox"/> Stock <input type="checkbox"/> Lawn <input type="checkbox"/> Oil field water <input type="checkbox"/> Other
TOP SOIL		0		12		9. Casing: Material <input type="checkbox"/> Height: Above or below Threaded <input type="checkbox"/> Welded <input type="checkbox"/> Surface 12 in. RMP <input checked="" type="checkbox"/> PVS <input type="checkbox"/> Weight 200 lbs./ft. Dia. 5 in. to 73 ft. depth Wall Thickness: 1/8 in. or Dia. <input type="checkbox"/> in. to <input type="checkbox"/> ft. depth gage No. 250
CLAY, LIGHT GREY		12		24		10. JESS & LOWELL Type SLOT Dia. 5" Slot/gauze 1/8 Length 75' Set between 68 ft. and 75 ft. Gravel pack? yes Size range of material 1/4 - 1/2"
SAND, LIGHT BROWN VERY FINE		24		32		11. Static water level: 32 ft. below land surface Date 10-12-78
ROCK 1/4" LIGHT BLACK		32		33		12. Pumping level below land surfaces: 32 ft. after 1 hrs. pumping 10 g.p.m. 32 ft. after 3 hrs. pumping 10 g.p.m. Estimated maximum yield 50 g.p.m.
CLAY RED		33		46		13. Water sample submitted: <input type="checkbox"/> Yes <input checked="" type="checkbox"/> No Date
SAND VERY FINE TO FINE		46		64		14. Well head completion: <input checked="" type="checkbox"/> Pitless adapter <input type="checkbox"/> Inches above grade
ROCK 1/4" TO 3/4"		64		73		15. Well grouted? yes With: <input checked="" type="checkbox"/> Neat cement <input type="checkbox"/> Bentonite <input type="checkbox"/> Concrete Depth: From 0 ft. to 12 ft.
CLAY BLUE		73		?		16. Nearest source of possible contamination: ft. 200 Direction E Type SEPTIC Well disinfected upon completion? <input checked="" type="checkbox"/> Yes <input type="checkbox"/> No
						17. Pump: Manufacturer's name RED JACKET Model number 1 HP 1/2 Volts 110 Length of drop pipe 60 ft. capacity 10 g.p.m. Type: <input checked="" type="checkbox"/> Submersible <input type="checkbox"/> Turbine <input type="checkbox"/> Jet <input type="checkbox"/> Reciprocating <input type="checkbox"/> Centrifugal <input type="checkbox"/> Other
						20. Water well contractor's certification: This well was drilled under my jurisdiction and this report is true to the best of my knowledge and belief. PESTINGER DRILLING 328 Business name SALINA, KS. License No. Address Salina, KS. Signed Steve Pestinger Date 11/2/78 Authorized representative
18. Elevation:		19. Remarks:				
Topography: <input type="checkbox"/> Hill <input checked="" type="checkbox"/> Slope <input type="checkbox"/> Upland <input type="checkbox"/> Valley						

Forward the white, blue and pink copies to the Department of Health and Environment

Form WWC-5