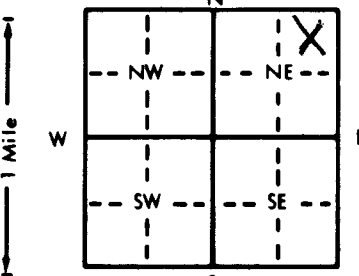


1 LOCATION OF WATER WELL: County: Saline Fraction: NW 1/4 NE 1/4 NE 1/4 Section Number: 9 Township Number: T 13 S Range Number: R 2

Distance and direction from nearest town or city street address of well if located within city?
5 miles North and 2 miles West of New Cambria, KS

2 WATER WELL OWNER: Rick Hunt
 RR#, St. Address, Box #: 6163 N. Holmes Road Board of Agriculture, Division of Water Resources
 City, State, ZIP Code: Salina, KS 67401 Application Number:

3 LOCATE WELL'S LOCATION WITH AN "X" IN SECTION BOX:


4 DEPTH OF COMPLETED WELL: 35 ft. ELEVATION:
 Depth(s) Groundwater Encountered 1. 6 ft. 2. 6 ft. 3. 6 ft.
 WELL'S STATIC WATER LEVEL: 6 ft. below land surface measured on mo/day/yr 5/14/87
 Pump test data: Well water was 10-15 gpm: Well water was 28 ft. after 1 hours pumping 12 gpm
 Est. Yield 10-15 gpm: Well water was 28 ft. after 1 hours pumping 12 gpm
 Bore Hole Diameter: 8 in. to 35 ft., and 35 in. to 35 ft.
 WELL WATER TO BE USED AS:
 5 Public water supply 8 Air conditioning 11 Injection well
 1 Domestic 3 Feedlot 6 Oil field water supply 9 Dewatering 12 Other (Specify below)
 2 Irrigation 4 Industrial 7 Lawn and garden only 10 Observation well
 Was a chemical/bacteriological sample submitted to Department? Yes.....No.....X...; If yes, mo/day/yr sample was submitted
 Water Well Disinfected? Yes X No

5 TYPE OF BLANK CASING USED:
 1 Steel 3 RMP (SR) 5 Wrought iron 8 Concrete tile CASING JOINTS: Glued Clamped
 2 PVC 4 ABS 6 Asbestos-Cement 9 Other (specify below) Welded
 7 Fiberglass Threaded
 Blank casing diameter 5 in. to 25 ft., Dia. 2.91 in. to 265 ft., Dia. 2.91 in. to 265 ft.
 Casing height above land surface: 12 in., weight 2.91 lbs./ft. Wall thickness or gauge No. 265
 TYPE OF SCREEN OR PERFORATION MATERIAL:
 1 Steel 3 Stainless steel 5 Fiberglass 8 RMP (SR) 10 Asbestos-cement 11 Other (specify)
 2 Brass 4 Galvanized steel 6 Concrete tile 9 ABS 12 None used (open hole)
 SCREEN OR PERFORATION OPENINGS ARE:
 1 Continuous slot 3 Mill slot 5 Gauzed wrapped 8 Saw cut 11 None (open hole)
 2 Louvered shutter 4 Key punched 6 Wire wrapped 9 Drilled holes
 7 Torch cut 10 Other (specify)
 SCREEN-PERFORATED INTERVALS: From 25 ft. to 35 ft., From 25 ft. to 35 ft., From 25 ft. to 35 ft.
 GRAVEL PACK INTERVALS: From 20 ft. to 35 ft., From 20 ft. to 35 ft., From 20 ft. to 35 ft.

6 GROUT MATERIAL: 1 Neat cement 2 Cement grout 3 Bentonite 4 Other
 Grout intervals: From 0 ft. to 20 ft., From 0 ft. to 20 ft., From 0 ft. to 20 ft.
 What is the nearest source of possible contamination:
 1 Septic tank 4 Lateral lines 7 Pit privy 10 Livestock pens 14 Abandoned water well
 2 Sewer lines 5 Cess pool 8 Sewage lagoon 11 Fuel storage 15 Oil well/Gas well
 3 Watertight sewer lines 6 Seepage pit 9 Feedyard 12 Fertilizer storage 16 Other (specify below)
 13 Insecticide storage
 Direction from well? None within 1/4 mile How many feet?

FROM	TO	LITHOLOGIC LOG	FROM	TO	LITHOLOGIC LOG
0	5	Top soil			
5	22	Black clay			
22	27	Silty clay			
27	29	Fine sand & crack gravel			
29	35	Gray shale			
35	45	Iron Pirite			
45	47	Gray shale			
47	50	Iron Pirite			
50	60	Gray shale			
60	63	Iron Pirite			
63	73	Gray shale			

*NOT CASED
 Plugged 35 to 73 ft*

7 CONTRACTOR'S OR LANDOWNER'S CERTIFICATION: This water well was (1) constructed, (2) reconstructed, or (3) plugged under my jurisdiction and was completed on (mo/day/year) 5-14-87 and this record is true to the best of my knowledge and belief. Kansas Water Well Contractor's License No. 138 This Water Well Record was completed on (mo/day/yr) 5-26-87 under the business name of Peterson Irrigation, Inc. by (signature) Mike Peterson

INSTRUCTIONS: Use typewriter or ball point pen. PLEASE PRESS FIRMLY and PRINT clearly. Please fill in blanks, underline or circle the correct answers. Send top three copies to Kansas Department of Health and Environment, Office of Oil Field and Environmental Geology, Regulation and Permitting Section, Topeka, Kansas 66620-7500, Telephone: 913-862-9360. Send one to WATER WELL OWNER and retain one for your records.

OFFICE USE ONLY
 T
 R
 EW
 SEC.